


SECTION 36 TOWNSHIP 12 S RANGE 15 W

WELL NO. # 1 Shaffer

COMPANY Franco Central

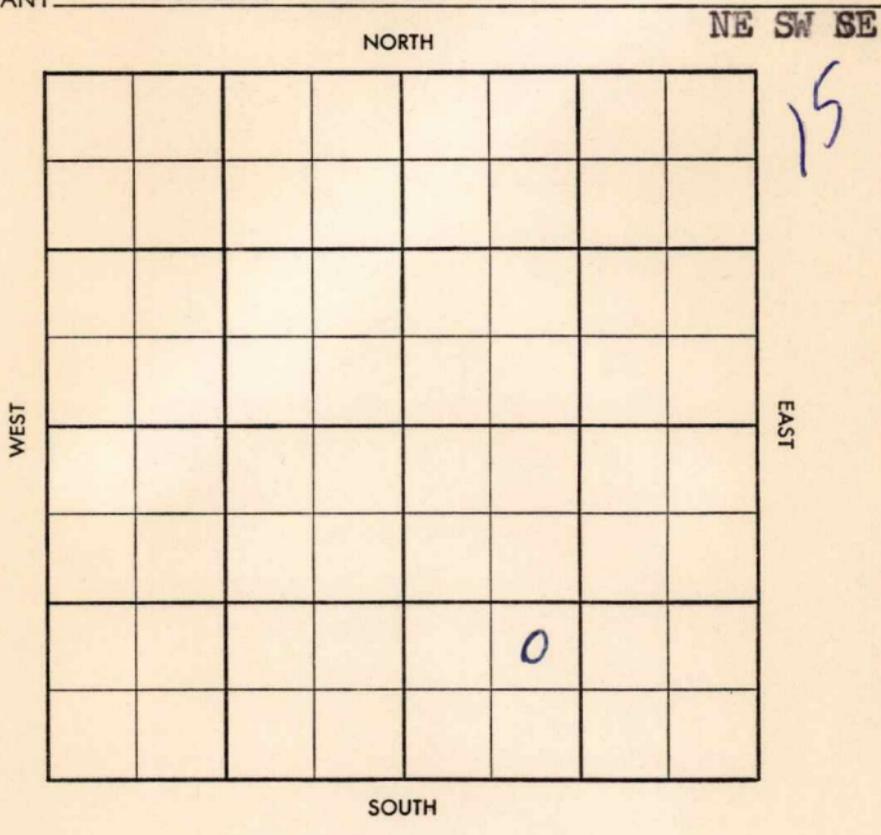

~~...~~
~~...~~

County Russell Elev. _____
Sec. 36 Twp. 12 Rge. 15W
Company Franco Central
Farm Name Shaffer No. 4

TOPS	DEPTH	LOG	DATUM
Anh.			
Tp.			
H.			
Tr.			
Dg.			
B.L.			
L.			
K.C.			
B.K.C.			
Ce.			
C.			
M.			
M.			
K.			
Mz.			
Mq.			
V.			
S.			
S.			
A.			
R.			
Pf.			
G.			
T.D.			

Loc. in Sec. NE SW SE

Geol. _____
Contr. Lewis Drlg

Pool S & S



Date Comm. 7-19-58
8" @ 855/375 drlg. 400

Co.
Use
No.
Sec.
T.
R.

S-513-B



County Russell Elev. 1777 OF 1780 RB
 Sec. 36 Twp. 12 Rge. 15W
 Company Franco Central
 Farm Name D Shaffer No. 4

TOPS	DEPTH	LOG	DATUM
Anh.			
Tp.			
H.	<u>2895</u>		
Tr.	<u>2913</u>		
Dg.			
B.L.			
L.	<u>3294</u>		
K.C.			
B.K.C.			
Ce.			
C.			
M.			
M.			
K.			
Mz.			
Mq.			
V.			
S.			
S.			
A.	<u>3294</u>		
R.			
Pf.			
G. Weather.	<u>3665</u>		
T.D.	<u>3666</u>		

Loc. in Sec. NE SW SE
 Geol. Bill Hall
 Contr. Lewis Drlg.
 Pool S S



Date Comm. 7-19-58
8" @ 855/375 drlg. 400 in 30 58 DST 2951
-60 -13" 13' M BHP 980-105
FP 0-25 DST 2989-3000 60"
275' SW BHP 505-455 FP 30-135
DST 3103-20 1 hr 608' SW BHP
0-965/20" FP 20-275
Ø 3229 AUG 6 58 5 1/2" 3333/700
CO 3666
SWDW &