

Barton

KANSAS


SECTION 32 TOWNSHIP 17 RANGE 12 W

WELL NO. #3 Heffner

COMPANY Bennett & Roberts

NORTH

7

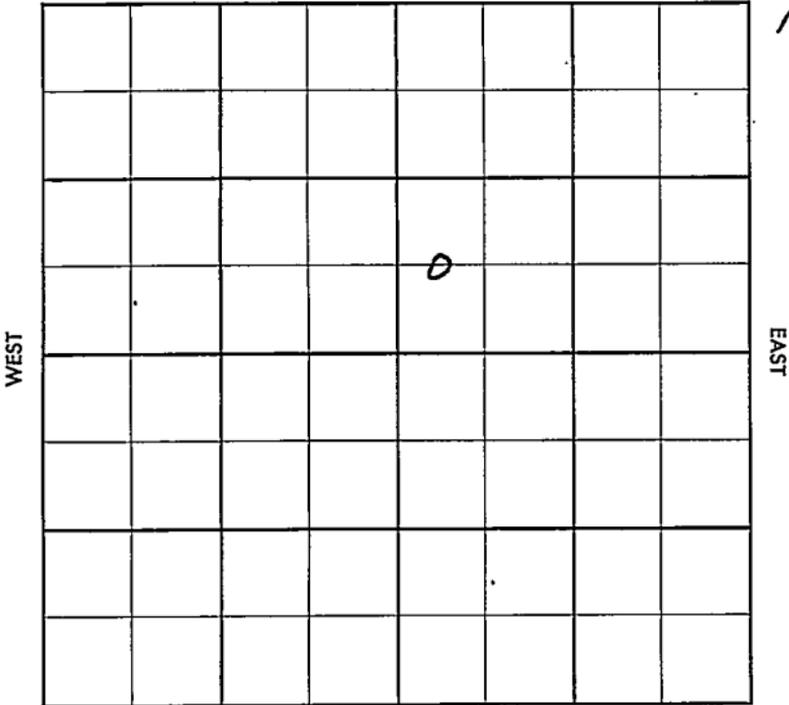

SOUTH

SEC. 32	TWP. 17	R. 12W
------------	------------	-----------

WELL NO.

#3 Heffner

FARM

COMPANY

Bennett & Roberts

CONTRACTOR


E. Redwing

_____ Ft. from N. Line

_____ Ft. from S. Line

_____ Ft. from E. Line

_____ Ft. from W. Line

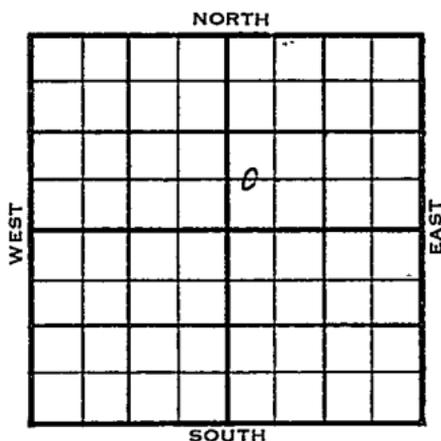C $W\frac{1}{2}$ SW NE

	ELEVATION	REPORT
1956	1830	

1-18 Comm. 1-14-56
8" @ 422
Drlg. 1325'

3/28 Comm 1-14-56

H	2992
Dodge	3011
Dg	3022
Bl	3088
L	3102
A	3350
TD	3351

8" @ 422

DST 3136-50 open 1 hr rec 960' oil
5 1/2" @ 3350 DD 3354 S/5 goph
1000 A S/7 boph
Comp 30 bopd

COMPLETED

County Barton Elev. _____
 Sec. 32 Twp. 17 Rge. 12W
 Company Bennett & Roberts
 Farm Name Heffner No. 3

TOPS	DEPTH	LOG	DATUM
Anh.			
Tp.			
H.			
Tr.			
Dg.			
Bl.			
L.			
K.C.			
B.K.C.			
Ce.			
C.			
M.			
M.			
K.			
Mz.			
Mq.			
V.			
S.			
S.			
A.			
R.			
PE.			
G.			
TD.			

Loc. in Sec. G W $\frac{1}{2}$ SW NE

Geol. _____

Contr. _____

Pool E. Redwing

JAN 18 1956	
	0

FIRST REPORT

Date Comm. 1-14-56
8" @ 422 drlg. 1325

Co.
Lsc.
No.
Sec.
T.
R.

~~15~~

