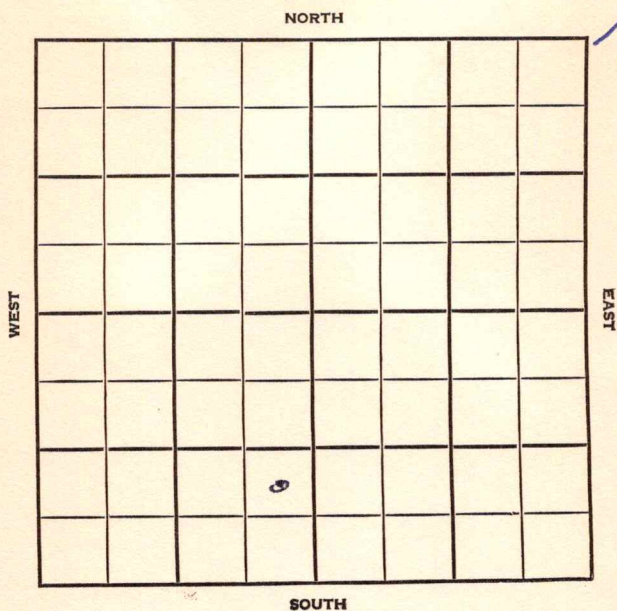


Ellis

Section 4 Township 13 Range 17WWell No. #2 Wolf "A"Company G*M*R Oil

Ellis

KANSAS

SEC.	TWP.	R.
4	13	17 W

WELL NO.

2 Wolf "A"

FARM

COMPANY

G-M-R Oil

CONTRACTOR

Toulon


Ft. from N. Line

Ft. from S. Line

Ft. from E. Line

Ft. from W. Line

NE SE SW

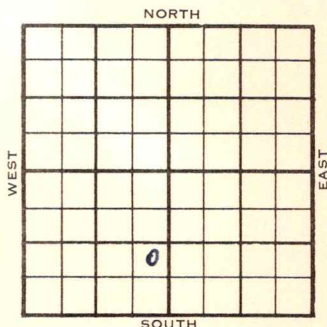

ELEVATION

REPORT

1955

2058'

6/15

Comm. 5-10-55

8-5/8" @ 202/125

DST 3345-65 open 1 hr rec 390' MW
990/20"DST 3408-21 open 20 min rec 90' gas,
90' HOCM, 340/10"

5 1/2" @ 3555/60 CO to 3523'

13/3408-12 1 qt/fluid 50% wtr.

500 A FU 300' oil. S/10 BOPH

6" wtr. S/10 BOPH 2% wtr.

Comp. 25 BOPD

L. 3342', C. 3576'

TD 3633'

FIRST REPORT

COMPLETED

County Ellis Elev. 2058
 Sec. 4 Twp. 13 Rge. 17W
 Company G-M-R Oil
 Farm Name Wolf "A" No. 2

TOPS	DEPTH	LOG	DATUM	Loc. in Sec.
Anh.				NE SE SW
Tp.				
H.				
Tr.				
Dg.				Geol.
Bl.				
L.	<u>3342</u>		<u>1284</u>	
K.C.				
B.K.C.				Contr.
Ce.				
C.	<u>3576</u>		<u>1518</u>	
M.				
M.				Pool
K.				
Mz.				
Me.				
V.				FIRST REPORT COMPLETE
S.				
S.				
A.				
R.				
Pf.				
G.				
T.D.	<u>3633</u>			

Date Comm. 5-10-55

JUN 15 1955

8 5/8" @ 202/125 DST 3345-65 open 1 hr.

Rec. 390' mw 990/20" DST 3408-21

open 20 min. Rec. 90' gas 90' hocm

340/10" 5 1/2" @ 3555/60 CO to 3523

13/ 3408-12 1 qt/ fluid 50% wtr.

500 A FU 300' oil S/ 10 boph 6% wtr

S/ 10 boph 2% wtr. Comp. 25 bopd