

KANSAS


FORM 51 5M 11-44 PETROL

Ellis County

Section 4 Township 13 Range 17W

Well No. #1 Wolf "B"

Company Hartman + Blair
~~H. H. Blair~~

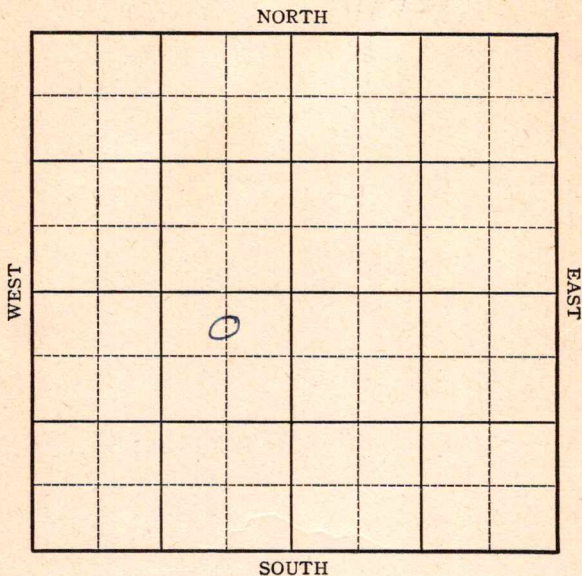

KANSAS

Sec. 4 Twp. 13 R. 17W

Well No. #1 Wolf "B" Farm

H. H. Blair Company

Catherine

330 Ft. from N. Line


330 Ft. from S. Line

660 Ft. from E. Line

 Ft. from W. Line

CN/NE SW

CSL SE NW

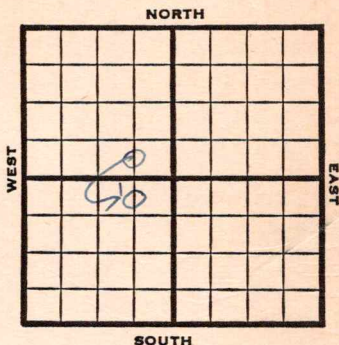

1946

Elev. 2069

REPORT

4/3

8" @ 190

Drlg. 1390'

4/10

Topeka 3065-3292

Lost Circulati on

4/17

Lans 3343

Arb. 3630

TD 3650'

ABANDONED


KANSASKansas Pool Name CatherineMap No. 71 Sec. 4 Twp. 13 R. 17WWell No. 1 Wolf "B"Hartman & Blair

Company

CORRECTION

Contractor

C N L NE SW

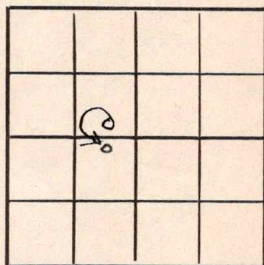SECTION PLAT330 Ft. from N. Line Ft. from S. Line660 Ft. from E. Line Ft. from W. LineEllis CountyLocation Rig up

Drilling and Remarks:

Reported

H. H. Blair

C S L SE NW

RECORDCased in., ft.Sand Gas Oil Total Depth **PRODUCTION**1st 24 hrs. Nat. 1st 24 hrs. after shot Gas Cu. Ft.Dry Hole Abandoned

Date

APR 10 1946 19S. J. LEWIS

Scout

KANSAS

Kansas Pool Name Catherine

No. 71 Sec. 4 Twp. 13 R. 17W

Well No. 1 Wolf "B"
Hartman & Blair Company

ABANDONED

C N L NE SW

Contractor

E 12068
SECTION PLAT

	o		

330 Ft. from N. Line

 Ft. from S. Line

660 Ft. from E. Line

 Ft. from W. Line

Ellis County

Location

Rig up

Drilling and Remarks:

Lone 3343
CR 4068
RECORD

Cased in., ft.

Sand

Gas

Oil

Total Depth 3650
PRODUCTION

1st 24 hrs. Nat.

1st 24 hrs. after shot

Gas Cu. Ft.

Dry Hole

Abandoned

Date

APR 17 1946

19

S. J. LEWIS Scout

Kansas Pool Name Catherine

KANSAS
 Map No. 171 Sec. 4 Twp. 13 R. 17W

Well No. 1 Wolf "B"H. H. Blair Company

FIRST REPORT

Contractor

C S L SE NW

SECTION PLAT

 Ft. from N. Line330 Ft. from S. Line660 Ft. from E. Line Ft. from W. LineEllis CountyLocation Rig up

Drilling and Remarks:

8" @ 190

Dr1g 1390

RECORD

Cased in., ft.Sand Gas Oil Total Depth

PRODUCTION

1st 24 hrs. Nat. 1st 24 hrs. after shot Gas Cu. Ft.Dry Hole Abandoned

Date

APR 3 1946 19S. J. LEWIS Scout