


Cowley

Map No. *Kans* Sec. *10* Twp. *33* R. *3*

Well No. *4 Henry Spruens Farm*

Rotana

Company

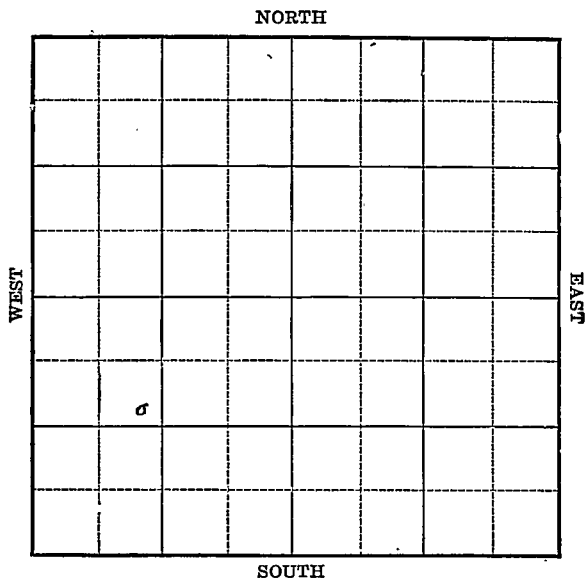

Location _____

Drilling Remarks

RECORD

Cased _____ in. _____ ft.

Sand _____

Gas _____

Oil _____

Total Depth _____

Rig Up _____

Drilling Remarks

PRODUCTION

1st 24 hrs. Nat. _____

1st. 24 hrs. after shot _____

Gas _____ cu. ft.

Dry Hole _____

Abandoned _____

Map No. KANSAS Sec. 10 Twp. 33 R. 3
 Well No. 4 Henry Spruce
Raymond Company

Contractor

FIRST REPORT

1620 Ft. from N. Line

----- Ft. from S. Line

----- Ft. from E. Line

1620 Ft. from W. Line

SECTION PLAT

o		c	

Location ✓✓

Rig up -----

Drilling and Remarks:

RECORD

Cased ----- in., ----- ft.

Sand -----

Gas -----

Oil -----

Total Depth -----

PRODUCTION

1st 24 hrs. Nat. -----

1st 24 hrs. after shot -----

Gas ----- Cu. Ft.

Dry Hole -----

Abandoned -----

Date

4/14 1925

M. A. BENEAR

Scout

Map No. **KANSAS** Sec. *10* Twp. *33* R. *3*

Well No. *4 Henry Spruen*

Rodman Pet. Company

Contractor

COMPLETED SECTION PLAT

1020 Ft. from N. Line

----- Ft. from S. Line

----- Ft. from E. Line

1020 Ft. from W. Line

a			

Location -----

Rig up -----

Drilling and Remarks:

swabbing 28 lbs oil
20 lbs water

RECORD

Cased ----- in., ----- ft.

Sand -----

Gas -----

Oil *3526-3528*

Total Depth *3528'*

PRODUCTION

1st 24 hrs. Nat. -----

1st 24 hrs. after shot -----

Gas ----- Cu. Ft.

Dry Hole -----

Abandoned -----

Date

MAY 20 1925.

M. A. BENEAR

----- 192-----

----- Scout