


Section 5 Township 13 Range 17W

Well No. #1 Karlin

Company Ben Brack

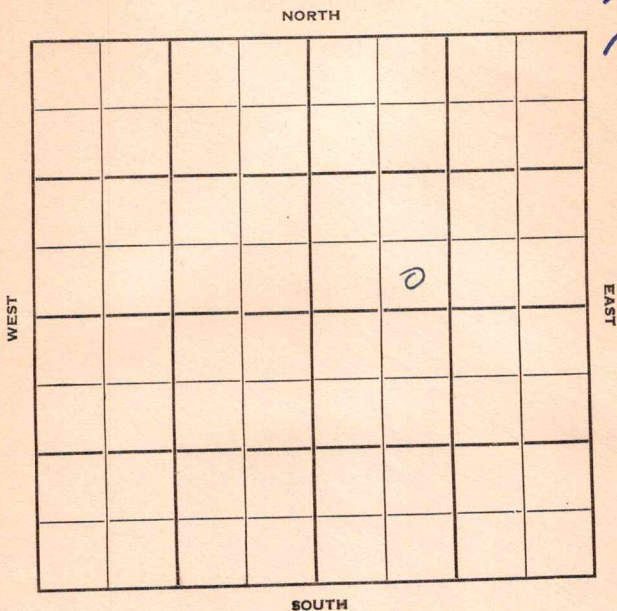

Ellis

KANSAS

Sec. 5 Twp. 13 R. 17W

Well No. #1 Karlin Farm

Ben Brack Company

Reed Pool

 Ft. from N. Line

330'


 Ft. from S. Line

 Ft. from E. Line

990'

 Ft. from W. Line

SE SW NE

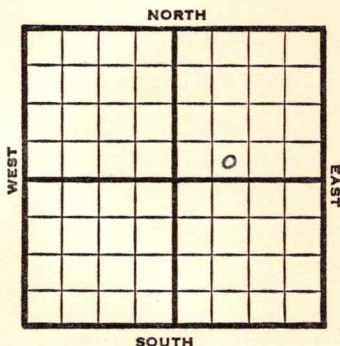

1950

Elev 2060'

REPORT

1/4

Moving in material

~~1950~~

1/18

TD 3650'

8"@ 125'

Anhy 1220'

KC 3340'

KC 3340'

BKC 3515'

Cong 3613-50

D&A

Aband.

ABANDONED

Kansas

Reed Pool

Map No. _____ Sec. 5 Twp. 13 R. 17WWell No. 1 Karlin

Ben Brack _____ Company

Contractor

SE S W NE


_____ Ft. from N. Line

330 Ft. from S. Line

_____ Ft. from E. Line

990 Ft. from W. Line

SECTION PLAT

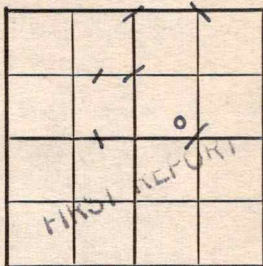

Ellis County

Location _____

Rig up _____

Drilling and Remarks:

Moving in material

RECORD

Cased _____ in., _____ ft.

Sand _____

Gas _____

Oil _____

Total Depth _____

PRODUCTION

1st 24 hrs. Nat. _____

1st 24 hrs. after shot _____

Gas _____ Cu. Ft.

Dry Hole _____

Abandoned _____


Date

JAN 4 1950JE. TYRA Scout

Map No. _____ Sec. 5 Twp. 13 R. 17WWell No. 1 KarlinBen Brack Company

Contractor

SE SW NE

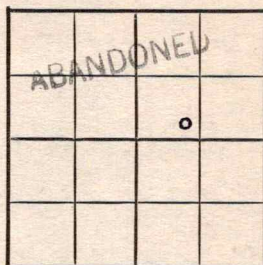EO-2060
SECTION PLAT

_____ Ft. from N. Line

330 Ft. from S. Line

_____ Ft. from E. Line

990 Ft. from W. Line

Ellis County

Location _____

Rig up _____

Drilling and Remarks:

8" @ 125
and 1220
KC 3340
BKC 3515
Cong 3613-50
D & A.

RECORD

Cased _____ in., _____ ft.

Sand _____

Gas _____

Oil _____

Total Depth 3650

PRODUCTION

1st 24 hrs. Nat. _____

1st 24 hrs. after shot _____

Gas _____ Cu. Ft.

Dry Hole _____

Abandoned _____

Date

JAN 18 1950

19

J. E. TYRA

Scout