


Butler

KANSAS

SECTION 33 TOWNSHIP 29 S RANGE 8 E

WELL NO. #2 Spence "B" #7 FEE "G"

COMPANY Beaumont Petr.

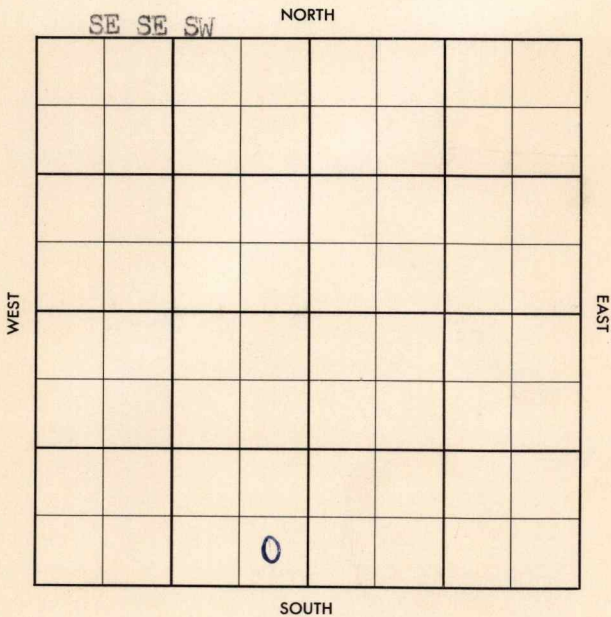

County Butler Elev. 1426 G
 Sec. 33 Twp. 29 Rge. 8E
 Company Beaumont Petroleum
 Farm Name Spence "E" "G" No. 7
FEE

TOPS	DEPTH	LOG	DATUM	Loc. in Sec.
Anh.				SE SE SW
Tp.				
H.				
Tr.				
Dg.				
BL.				
L.				
K.C.	<u>1297</u>			Geol.
B.K.C.				Contr.
Ce.				
C.				
M.				
M.				Pool
K.				Hannah
Mz.				
Mq.				
V.				
S.				
S.				
A.				
R.				
PE.				
G.				
T.D.	<u>2099</u>			
	<u>2100</u>			

COMPLETE	
SEP 25 57	
0	

Date Comm. 8" @ 60/50, MIRT SEP 4 57 5 1/2 2057
SEP 11 57 DD 2089 FU 375 0
no W 12 hrs 750 acid
SEP 18 57 F/W 44-50 130
SEP 25 57 1500A N POP
10 Bop down W