


Map No. Kansas Sec. 33 Twp. 29 R. 8Well No. 8 Hanna Farm
C. E. Roth Company

NORTH

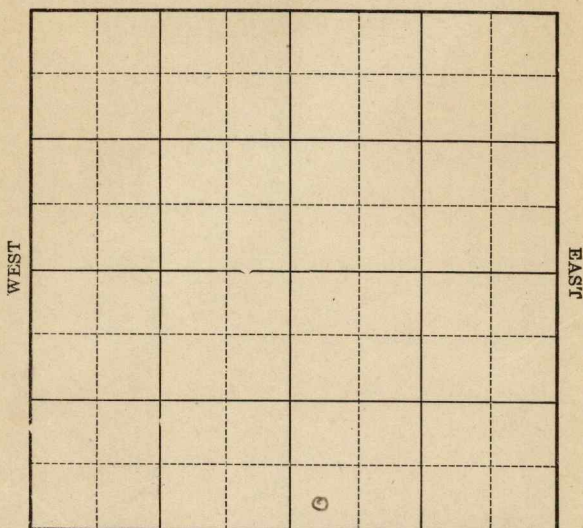

SOUTH

Location _____

Drilling Remarks _____

RECORD

Cased _____ in. _____ ft.

Sand _____

Gas _____

Oil _____

Total Depth _____

Rig Up _____

Drilling Remarks _____

PRODUCTION

1st 24 hrs. Nat. _____

1st 24 hrs. after shot _____

Gas _____ cu. ft.

Dry Hole _____

Abandoned _____

Butler Co

Map No. Kansas Sec. 33 Twp. 29 R 8Well No. 8 Hanna Farm
C.E. Roth Company

NORTH

WEST

EAST

SOUTH

Ft. from N. Line

250 Ft. from S. Line

Ft. from E. Line

250 Ft. from W. Line

Date

REPORT

1/261/20Timbers1/272/42/102/172/24SLg 15503/53/10SLg 12603/183/254/14/7Sand 2120-2154 80 gts
25 bbls

Butler Co

K10 Map No. **KANSAS** Sec. **33** Twp. **29** R. **8**Well No. **8** **Hanna****E. E. Roth**

Company

Contractor

FIRST REPORTS

Ft. from N. Line

250

Ft. from S. Line

Ft. from E. Line

250

Ft. from W. Line

SECTION PLAT

Location

Rig up

Drilling and Remarks:

Timbers

RECORD

Cased _____ in., _____ ft.

Sand _____

Gas _____

Oil _____

Total Depth _____

PRODUCTION

1st 24 hrs. Nat. _____

1st 24 hrs. after shot _____

Gas _____ Cu. Ft.

Dry Hole _____

Abandoned _____

Date

JAN 20 1926**192****CHAS. I. SHEPWOOD**

Scout

10 KANSAS 33
 Map No. _____ Sec. _____ Twp. 29 R. 8
 Well No. 18 Hanna
 O. E. Roth _____ Company
 _____ Contractor

COMPLETED

SECTION PLAT

		0	

_____ Ft. from N. Line

 250
 _____ Ft. from S. Line

_____ Ft. from E. Line

 250
 _____ Ft. from W. Line

Location _____

Rig up _____

Drilling and Remarks:

Bay 25 BS.

RECORD

Cased _____ in., _____ ft.

Sand 2120-2154'

Gas _____

Oil _____

Total Depth 2154'

PRODUCTION

1st 24 hrs. Nat. _____

1st 24 hrs. after shot. _____

Gas _____ Cu. Ft.

Dry Hole _____

Abandoned _____

Date

APR 7 1926

192

CHAS. L. SHERWOOD

Scout