


Map No. _____ Sec. 33 Twp. 29 R. 8
 Well No. 10 - Hanna Farm _____
Roth et al Company _____

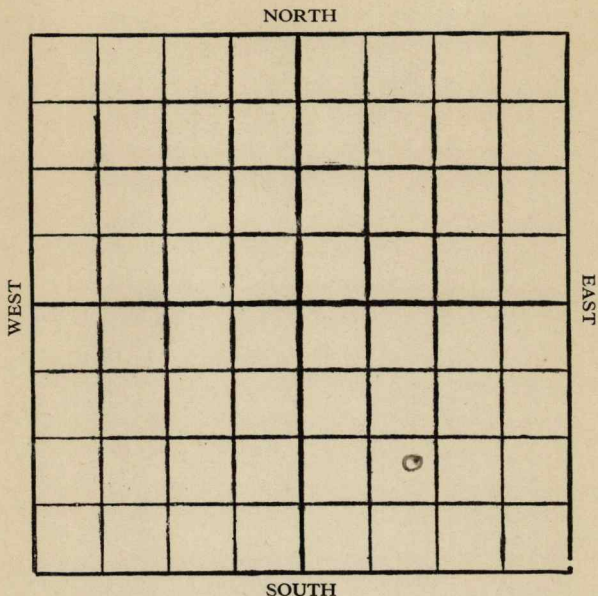

Location _____
 Drilling Remarks _____

Rig Up _____
 Drilling Remarks _____

RECORD

Cased _____ in. _____ ft.
 Sand _____
 Gas _____
 Oil _____
 Total Depth _____

PRODUCTION

1st 24 hrs. Nat. _____
 1st 24 hrs. after shot _____
 Gas _____ cu. ft.
 Dry Hole _____
 Abandoned _____


Kansas

Map No. _____ Sec. 33 Twp. 29 R. 8Well No. 10 - Hanna FarmRothlial Company

_____ Ft. from N. Line

1120 Ft. from S. Line

_____ Ft. from E. Line

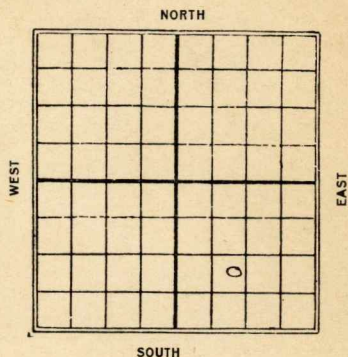1120 Ft. from W. Line1927

Date

REPORT

2/3 Drlg 800'2/102/172/243/23/93/16Drlg 1930Sand 2098-2119 120 gts.
15 bbls.

10 **KANSAS** Sec. 33 Twp. 29 R. 8

Well No. 10 Hanna
Roth et al Company

Contractor

COMPLETED

SECTION PLAT

_____ Ft. from N. Line

1120 _____ Ft. from S. Line

_____ Ft. from E. Line

1120 _____ Ft. from W. Line

Location _____

Rig up _____

Drilling and Remarks:

RECORD

Cased _____ in. _____ ft.

Sand 2098 2119

Gas _____

Oil _____

Total Depth 2119

PRODUCTION

1st 24 hrs. Nat. _____

1st 24 hrs. after shot _____

Gas _____ Cu. Ft.

Dry Hole _____

Abandoned _____

Date

MAR 16 1927

CHAS. L. SHERWOOD

192

Scout

Map No. 10 **KANSAS** Sec. 33 Twp. 29 R. 8
 Well No. 10 Donna
Both et al Company _____

Contractor _____

FIRST REPORTS**SECTION PLAT**

_____ Ft. from N. Line

1120 Ft. from S. Line

_____ Ft. from E. Line

1120 Ft. from W. Line

		o	

Location _____

Rig up _____

Drilling and Remarks:

Only 800'**RECORD**

Cased _____ in., _____ ft.

Sand _____

Gas _____

Oil _____

Total Depth _____

PRODUCTION

1st 24 hrs. Nat. _____

1st 24 hrs. after shot _____

Gas _____ Cu. Ft.

Dry Hole _____

Abandoned _____

Date

DEC 3 1927

192

CHAS. L. SHERWOOD

Scout