

Ellis

KANSAS

SECTION 5 TOWNSHIP 13 RANGE 17W

WELL NO. #2 Karlin "B"

COMPANY Aylward Drlg.

NORTH

							0

SOUTH

WEST

EAST

8

Ellis

KANSAS

SEC.	TWP.	R.
5	13	17 W

WELL NO.

2 Karlin "B"

FARM

COMPANY

Aylward Drlg.

CONTRACTOR


NW Catherine

Ft. from N. Line

Ft. from S. Line

Ft. from E. Line

Ft. from W. Line

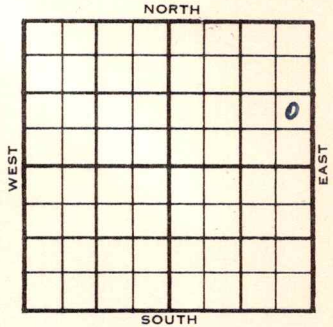

NE SE NE

SDX Lse - 1/2 Mile

	ELEVATION	REPORT
1956	2073'	

4/4	Cellar & Pits
4-12	Moving in rotary
4-19	Spud 4-11-56 8 5/8" @ 108 w/90 Anhy 1270 Drlg. 3225
4-25	DST 3343-87 op 1/2 hr. rec. 30' mud, 905/15" D & A H. 3309 Tr. 3328 L. 3356 C. 3606 TD 3640'

ABANDONED

County Ellis Elev. 2073
 Sec. 5 Twp. 13 Rge. 17W
 Company Aylward Drilg.
 Farm Name Karlin "B" No. 2

TOPS

DEPTH

LOG

DATUM

Loc. in Sec.

Anh.

NE SE NE

Tp.

H.

3309

Tr.

3328

Dg.

Bl.

L.

33561283

K.C.

Geol.

B.K.C.

Ce.

Contr.

C.

36061533

Co. tools

M.

M.

Pool

K.

NW Catherine

Mz.

Mq.

V.

S.

S.

A.

R.

P.E.

G.

T.D.

3640

ABANDONED

Date Comm. 4-11-56

APR 25 1956

8 5/8" @ 108/90 DST 3343-87open 1/2 hr. Rec. 30' mud 905/15"

D & A

County **Ellis** Elev. **2073**
 Sec. **5** Twp. **13** Rge. **17W**
 Company **Aylward Drlg.**
 Farm Name **Karlin "B"** No. **2**

TOPS

DEPTH

LOG

DATUM

Loc. in Sec.

Anh.

NE SE NE

Tp.

H.

Tr.

Dg.

B.L.

L.

K.C.

Geol.

B.K.C.

Contr.

Ce.

C.

M.

M.

K.

Pool

Mz.

NW Catherine

Mq.

V.

S.

S.

A.

R.

P.E.

G.

FIRST REPORT

T.D.

APR 4 '56

Date Comm.

Cellar & pits

14