

GEOLOGICAL DEPARTMENT
SOUTHWESTERN GAS COMPANY
INDEPENDENCE, KANSAS

Company

Contractor

Drilling
Commenced

Drilling
Completed


Initial
Production

Initial Rock
Pressure

Location **SW of the NW of the NE.**

Casing

S. T. R. 6-29-9
County Elk
State Kansas
Lease and Barnes #1
Well No.

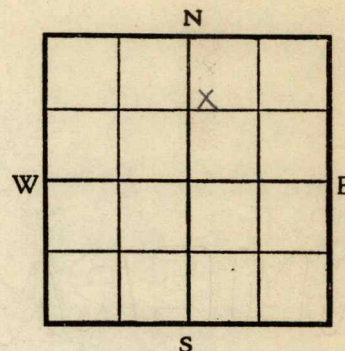

Driller's Record of Formations

red rock	900	905
lime	905	922
shale	922	960
lime shells	960	970
white cavings	970	985
shale	985	997
sand H.F.W.	997	1035
slate	1035	1040
sand H.F.W.	1040	1055
slate	1055	1070
sand H.F.W.	1075	1175
lime	1175	1198
slate	1198	1203
lime	1203	1303
sand H.F.W.		1305
lime	1305	1400
shale	1400	1532
lime	1532	1548
slate H.F.W.	1548	1570
lime	1570	1643
H.F.W.		1668
lime sandy	1668	1685
shale	1685	1691
sand stray oil		
shale	1691	1708
lime & slate	1708	1720
slate	1720	1730
lime oil show	1730	1724
oil sand	1724	1751