

Butler


KANSAS

SECTION 33 TOWNSHIP 29S RANGE 8E

WELL NO. #8 Fee "G"

COMPANY Beaumont Petroleum

NORTH C S/2 SE

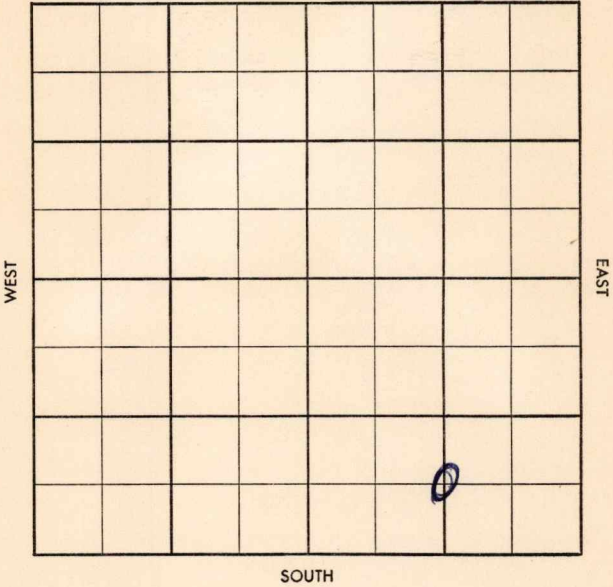

County Butler Elev. 1447.6 F
 Sec. 33 Twp. 29 Rge. 8E
 Company Beaumont Petroleum
 Farm Name Fee "G" No. 8

TOPS	DEPTH	LOG	DATUM
Anh.			
Tp.			
H.			
Tr.			
Dg.			
B.L.			
L.			
K.C.	1914		
B.K.C.	2093		
Ce.			
C.			
M.			
M.			
K.			
Mz.			
Mq.			
V.			
S.			
S.			
A.			
R.			
Pf.			
G.			
T.D.	2109		

Loc. in Sec. C S/2 SE

Geol. _____
 Contr. _____
 Pool Hannah

ABANDONED
 FEB 19 1958

Date Comm. 1/15/58, 10" @ 70 w/45, tops. 7"
@ 2109 w/35, WOC TD 2109

FEB 12 '58 DD 2118 TD / 2 Tstg
 FEB 19 '58 B 220 pd NW

T-6A

Co.
Lse.
No.
Sec.
T.
R.

30

County Butler Elev. _____
 Sec. 33 Twp. 29 Rge. 8E
 Company Beaumont Petroleum
 Farm Name Fee "G" No. 8

TOPS	DEPTH	LOG	DATUM
Anh.			
Tp.			
H.			
Tr.			
Dg.			
B. L.			
L.			
K.C.	1914		
B.K.C.	2093		
Ce.			
C.			
M.			
M.			
K.			
Mz.			
Mq.			
V.			
S.			
S.			
A.			
R.			
Pf.			
G.			
T.D.	2109		

Loc. in Sec. C S/2 SE
 Geol. _____
 Contr. _____
 Pool Hannah

JAN 22 '58
FIRST REPORT

Date Comm. 1/15/58, 10" @ 70 w/45, tops. 7"
 © 2109 w/35, WOC TD 2109

Co.
 Lse.
 No.
 Sec.
 T.
 R.