


Butler

KANSAS

SECTION 33 TOWNSHIP 29 RANGE 8E

WELL NO. #9 Fee "G"

COMPANY Beaumont Petroleum

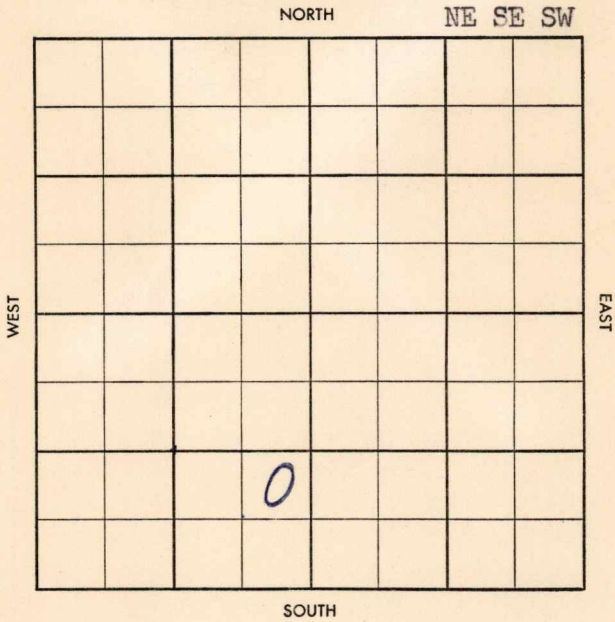

30

S-513-B

County Butler Elev. \_\_\_\_\_  
 Sec. 33 Twp. 29 Rge. 8E  
 Company Beaumont Petroleum  
 Farm Name Fee "Q" No. 9

TOPS	DEPTH	LOG	DATUM
Anh.			
Tp.			
H.			
Tr.			
Dg.			
B. L.			
L.			
K.C.			
B.K.C.			
Ce.			
C.			
M.			
M.			
K.			
Mz.			
Mq.			
V.			
S.			
S.			
A.			
R.			
Pf.			
G.			
T.D.			

Loc. in Sec. \_\_\_\_\_  
NE SE SW  
 Geol. \_\_\_\_\_  
 Contr. \_\_\_\_\_  
 Pool \_\_\_\_\_  
Hannah

**FIRST REPORT**  
 JAN 22 '39

Date Comm. \_\_\_\_\_  
10" @ 60 WORT

Co.  
Lse.  
No.  
Sec.  
T.  
R.

County Butler Elev. 1423KB  
 Sec. 33 Twp. 29 Rge. 8E  
 Company Beaumont Petroleum  
 Farm Name Fee "G" No. 9

TOPS	DEPTH	LOG	DATUM
Anh.			
Tp.			
H.			
Tr.			
Dg.			
B.L.			
L.			
K.C.	<u>1895</u>		
B.K.C.	<u>2067</u>		
Ce.			
C.			
M.			
M.			
K.			
Mz.			
Mq.			
V.			
S.			
S.			
A.			
R.			
Pf.			
G.			
T.D.	<u>2083</u>		

Loc. in Sec. NE SE SW

Geol. \_\_\_\_\_  
 Contr. \_\_\_\_\_  
 Pool Hannah

FEB 26 '58  
 COMPLETE

Date Comm. 10" @ 60 WORT JAN 29 '58 7" 2083 WIC

FEB 5 '58 FEB 12 '58 FEB 19 '58 MICT FEB 26 '58 DD  
2087 TD @ 550 NW NT A  
P 10 80 + 2 BWpd

⌘

Co.  
 Use.  
 No.  
 Sec.  
 T.  
 R.