


Butler Co

Map No. Kansas Sec. 33 Twp. 29 R 8

Well No. 6 Hannah Farm

C.E. Roth + Co Company

NORTH

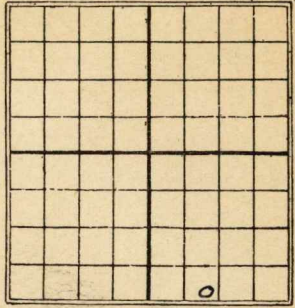

..... Ft. from N. Line

200 Ft. from S. Line

..... Ft. from E. Line

1120 Ft. from W. Line

1st + Completed

SOUTH

Date

1925

REPORT

7/3 2126-2153 70 gts

50 Bbls

~~7/3~~

Butler Co

Map No. ¹⁰ KANSAS Sec. ³³ Twp. ²⁹ R. ⁸

Well No. ¹⁶ ^{Hannah}
C. E. Bothe Co Company

Contractor

FIRST REPORTS
COMPLETED

SECTION PLAT

_____ Ft. from N. Line
²⁰⁰ _____ Ft. from S. Line
_____ Ft. from E. Line
¹¹²⁰ _____ Ft. from W. Line

			0

Location _____

Rig up _____

Drilling and Remarks:

^{70/50 bks.}

RECORD

Cased _____ in., _____ ft.
Sand ^{2126-2153'}
Gas _____
Oil _____
Total Depth ^{2153'}

PRODUCTION

1st 24 hrs. Nat. _____
1st 24 hrs. after shot _____
Gas _____ Cu. Ft.
Dry Hole _____
Abandoned _____

Date

SEP 3 1925

CHAS. L. SHERWOOD

192

Scout