

Well No. 7 Hanna Farm

Roth & Frazer Company

WEST

EAST

SOUTH

Rig Up_____

Drilling Remarks

PRODUCTION

1st 24 hrs. Nat.

1st 24 hrs. after shot _____

Gas _____ cu. ft.

Dry Hole

Abandoned

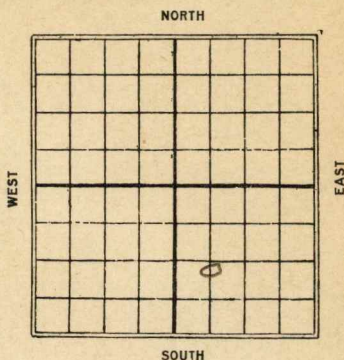
Butler Co

Map No. Kansas Sec. 33 Twp. 29 R. 8Well No. 7 Hanna FarmRoth and Fawcett Company

Ft. from N. Line

1120 Ft. from S. Line

Ft. from E. Line

660 Ft. from W. Line

Date

REPORT

192512/17 Dulling 130012/23 Drlg 1575'12/31 S.D. 1575'19261/8 —1/14 —1/20 Sand 2098-2195 120 gts
70 Bbls

Butcher Co.

Map No. KANSAS 10 33 Sec. 29 Twp. 29 R. 8Well No. 7 Anna
Both and Laura Company

Contractor

SECTION PLAT

		o	

Ft. from N. Line

1120

Ft. from S. Line

Ft. from E. Line

660

Ft. from W. Line

FIRST REPORTS

Location

Rig up

Drilling and Remarks:

only 1300'

RECORD

Cased _____ in., _____ ft.

Sand _____

Gas _____

Oil _____

Total Depth _____

PRODUCTION

1st 24 hrs. Nat. _____

1st 24 hrs. after shot _____

Gas _____ Cu. Ft.

Dry Hole _____

Abandoned _____

Date

DEC 17 1925

CHAS. L. SHERWOOD

192

Scout

Butter Co

8

K10 KANSAS 33 Map No. Sec. 29 Twp. R.

Well No. 1 Hanna

Roth & Laura Company

Contractor

COMPLETED

SECTION PLAT

		o	

Ft. from N. Line

1120 Ft. from S. Line

Ft. from E. Line

660 Ft. from W. Line

Location

Rig up

Drilling and Remarks:

RECORD

Cased in. ft.

Sand 2098-2195

Gas

Oil

Total Depth 2195

PRODUCTION

1st 24 hrs. Nat.

1st 24 hrs. after shot

Gas Cu. Ft.

Dry Hole

Abandoned

Date

JAN 20 1926

192

CHAS. L. SHERWOOD

Scout

120/70 bhs.