

Sec. 6 Twp. 29 Range 9E

1 Barnes

Kansas Geological Society

Junker, et al.

Skelly Scout Tickets

Map No. _____ Sec. 6 Twp. 29 R. 9

Well No. 1 Barnes Farm _____
Junker Eval Company _____

NORTH

200 Ft. from N. Line


_____ Ft. from S. Line

200 Ft. from E. Line

_____ Ft. from W. Line

WEST

EAST

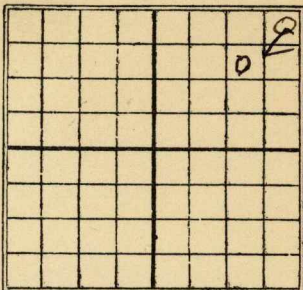

SOUTH

Date

REPORT

1923

2/6

Rig

8/4

S.D. 988'

1924

1/18

D & d 1770'

Map No. **KANSAS** ¹⁰ Sec. ⁶ Twp. ²⁹ R. ⁹

Well No. ^{1 Barnes}

^{Junker et al.} Company

Contractor

ABANDONED


SECTION PLAT

^{1120'} Ft. from N. Line

----- Ft. from S. Line

----- Ft. from E. Line

^{200'} Ft. from W. Line

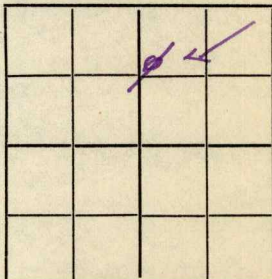

Location -----

Rig up -----

Drilling and Remarks:

^{LD 491770'}

RECORD

Cased ----- in., ----- ft.

Sand -----

Gas -----

Oil -----

Total Depth -----

PRODUCTION

1st 24 hrs. Nat. -----

1st 24 hrs. after shot -----

Gas ----- Cu. Ft.

Dry Hole -----

Abandoned -----

Date

^{JAN 18 1924}

192

M. A. BENEAR

Scout

Map No. KANSAS¹⁰ Sec. 6 Twp. 29 R. 9Well No. 1 BarnesJanber et al Company

Contractor

FIRST REPORT

SECTION PLAT

200 Ft. from N. Line

Ft. from S. Line

200 Ft. from E. Line

Ft. from W. Line

			0

Location

Rig up ✓

Drilling and Remarks:

RECORD

Cased _____ in., _____ ft.

Sand _____

Gas _____

Oil _____

Total Depth _____

PRODUCTION

1st 24 hrs. Nat. _____

1st 24 hrs. after shot _____

Gas _____ Cu. Ft.

Dry Hole _____

Abandoned _____

Date FEB 6 1923

M. A. BENEAR

191

Scout