


Barton

KANSAS

SECTION 1 TOWNSHIP 17S RANGE 13W

WELL NO. #1 Nagel

COMPANY Lee Phillips

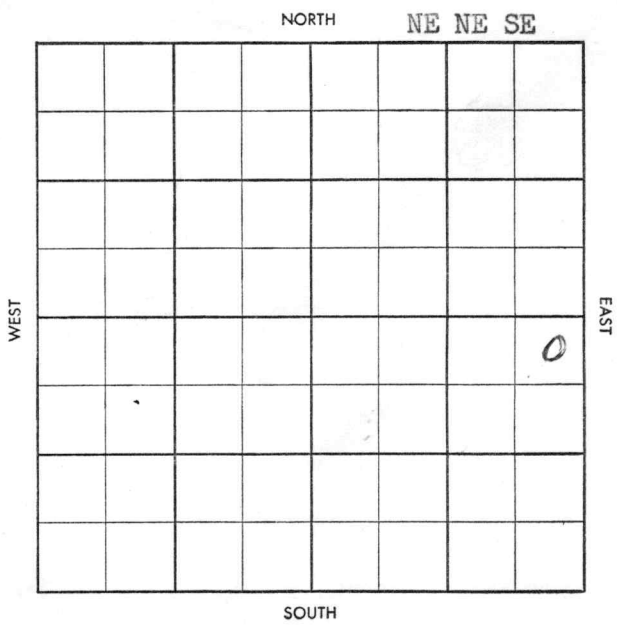

~~Twp. Pool~~
~~Co. Fac.~~
WILDCAT

S-513-B

County Barton Elev. _____
 Sec. 1 Twp. 17 Rge. 13W
 Company Lee Phillips
 Farm Name Nagel No. 1

TOPS	DEPTH	LOG	DATUM
Anh.			
Tp.			
H.			
Tr.			
Dg.			
B.L.			
L.			
K.C.			
B.K.C.			
Ce.			
C.			
M.			
M.			
K.			
Mz.			
Mq.			
V.			
S.			
S.			
A.			
R.			
Pf.			
G.			
T.D.			

Loc. in Sec. _____

NE NE SE


Geol. _____

Contr. _____

Harms-Burt

Pool _____

Wildcat

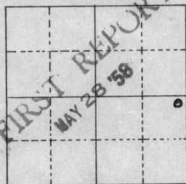

Date Comm. _____

WORT

Co.

Lse.

No.

Sec.

T.

R.

Twp. X Pool X
 Co. X Facet X

S-513-B

County Barton Elev. 1967 DE 117 1/2
 Sec. 1 Twp. 17 Rge. 13W
 Company Lee Phillips
 Farm Name Nagel No. 1

TOPS	DEPTH	LOG	DATUM
Anh.	<u>854</u>		
Tp.			
H.	<u>3088</u>		
Tr.			
Dg.			
B.L.	<u>3178</u>		
L.	<u>3196</u>		
K.C.			
B.K.C.			
Ce.			
C. <u>shly</u>	<u>3428</u>		
M.			
M.			
K.			
Mz.			
Mq.			
V.			
S.			
S.			
A.	<u>3440</u>		
R.			
Pf.			
G.			
T.D.	<u>3449</u>		

Loc. in Sec. NE NE SE
 Geol. _____
 Contr. Harms-Burt
 Pool Wildcat



Date Comm. 6-3-58 8" 560/400
 WORT JUN 3 '58 JUN 11 '58 DST 3201-24 JUN 18 '58

60" 7'M +/- oil BHP 0 no log

D 6 A

Co.
 Sec.
 No.
 T.
 R.