

Well No. 1- Wascom Farm

F. F. Fleming & Co. Company

NORTH

WEST

EAST

0

SOUTH

Location _____

Drilling Remarks

Rig Up _____

Drilling Remarks

RECORD

Cased _____ in. _____ ft.

Sand _____

Gas _____

Oil _____

Total Depth_____

PRODUCTION

1st 24 hrs. Nat. _____

1st 24 hrs. after shot_____

Gas_____cu. ft._____

Dry Hole_____

Abandoned _____


Map No. **KANSAS** Sec. 9 Twp. 29 R. 9^E
 Well No. 1- Bascom Farm
F. F. Fleming et al Company

 Ft. from N. Line

330 Ft. from S. Line

 Ft. from E. Line

330 Ft. from W. Line

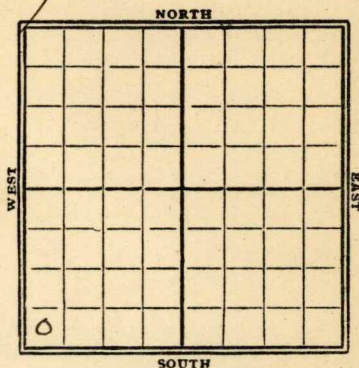

1929

Date

REPORT

8/14	Rgn up - mach
8/21	
8/28	1400
9/4	" 425'
9/11	SD. 425'
9/18	Drly 850'
9/25	" 1000'
10/2	" 1340'
10/9	" 1410'
10/16	" 1800'
10/23	" 2310'
10/30	SD. 2310'
11/6	Top line 2314
	drly 2360'
11/13	" 2444'
11/20	Base line 2592'
	drly 2634'
11/27	Wilcox 2639-41
	1900' oil in 18 hours
	swab 80 bbl 5 hrs.
	33° at 58'
	show water

12/4- Top line 2314-2592
" Wilcox 2639-41
T.D. 2641'

pump 80 bbl oil
Pump.

10
Map No. **KANSAS** Sec. 9 Twp. 29 R. 9

Well No. 1 *Bascom*

J. J. Fleming et al Company

Contractor

COMPLETE

SECTION PLAT

..... Ft. from N. Line

330 Ft. from S. Line

..... Ft. from E. Line

330 Ft. from W. Line

0			

Location.....

Rig up.....

Drilling and Remarks:

Top line 2314-2592

Pumping 80 Bls

RECORD

Cased..... in., ft.

Sand *Wilcox* *7639-7641*

Gas.....

Oil.....

Total Depth *7641*

PRODUCTION

1st 24 hrs. Nat.....

1st 24 hrs. after shot.....

Gas..... Cu. Ft.

Dry Hole.....

Abandoned.....

Date

DEC 4 1929

192.....

CHAS. L. SHERWOOD

Scout

Map No. **KANSAS** Sec. 9 Twp. 29 R. 9E

Well No. 1 Bascom

F. F. Fleming & Co Company

Contractor

FIRST REPORTS

SECTION PLAT

_____ Ft. from N. Line

330 Ft. from S. Line

_____ Ft. from E. Line

330 Ft. from W. Line

Location _____

Rig up _____

Drilling and Remarks:

*Wack
Rigging up*

RECORD

Cased _____ in., _____ ft.

Sand _____

Gas _____

Oil _____

Total Depth _____

PRODUCTION

1st 24 hrs. Nat. _____

1st 24 hrs. after shot _____

Gas _____ Cu. Ft.

Dry Hole _____

Abandoned _____

Date

AUG 14 1929

CHAS. L. SHERWOOD

19

Scout