
FORM 51 25M 3-49 PETROL Barton KANSAS

Section 36 Township 17 Range 12 W

Well No. # 1 Stueder

Company Alpine Oil & Royalty

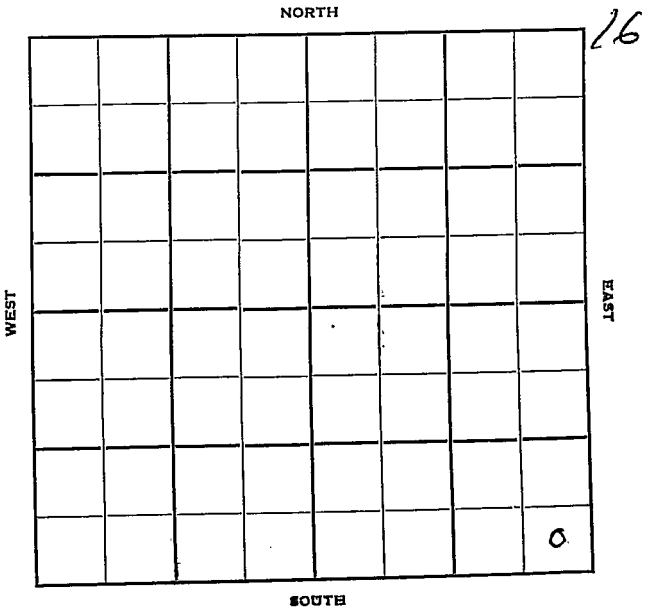

FORM 252-B
10M 11-50 PETROL

Barton

KANSAS

Sec. 36 Twp. 17 R. 12W

Well No. #1 Stueder Farm

Alpine Oil & Royalty Company

Quaker Drlg. Contractor

Wildcat


____ Ft. from N. Line

330 Ft. from S. Line

330 Ft. from E. Line

____ Ft. from W. Line

SE SE SE

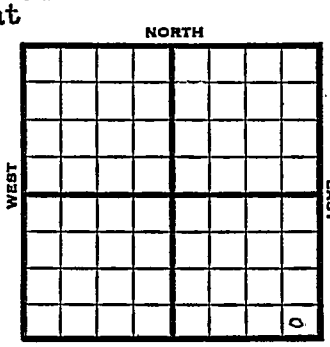

Sohio DHM

1951 REPORT

Elev. 1825'

10/3 Spud 9-29-51
8" @ 200
Anhy 675
Drlg. 1700

10/31 Spud 9-29-51
D & A TD 3385' 8" @ 200
Anhy 675' Heeb 2939' Br. lime 304[illegible]
Lans. 3063'
DST 3066-3100 open 1 hr. rec 18' mud
DST 3239-64 open 45 min. rec 125' HOCM
Cong 3320' Arb. 3371' 5" @ 3379
TD 3385' water PB 3325' 24/3260-66
500 A 1½ BOPH 16/3256-60 1000 A
S/2 BOPH PB 3080 32/3060-68
500 A S/50 GW SSO S/ 3/4 GW
5 hr.
D & A

ABANDONED

FORM 275 FOR SALE BY KANSAS BLUE PRINT CO.


County Barton State Kansas

Sec. 36 (Blk. Twp.) 17 (Sur. Rge.) 12W Map No.

Operator Alpine Oil & Royalty

Well No. 1 Farm Stueder

Elev. Location SE SE SE

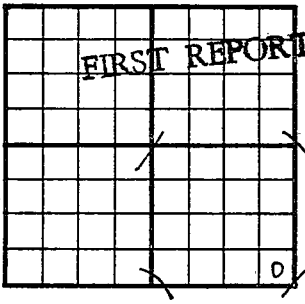

330 Ft. From S Line SE

330 Ft. From E Line Quarter

1st. Report OCT 3 1951

Completion

Remarks Sohio DHM
Quaker Drlg. - Contr.

Spudding Date 9-29-51

Drlg. Data Wildcat

8" @ 200 Anhy 675 drlg. 1700

J. E. TYRA

FORM 275 FOR SALE BY KANSAS BLUE PRINT CO.


County Barton State Kansas

Sec. 36 (Blk. Twp.) 17 (Sur. Rge.) 12W Map No.

Operator Alpine Oil & Royalty

Well No. 1 Farm Stueder

Elev. 1825 Location SE SE SE

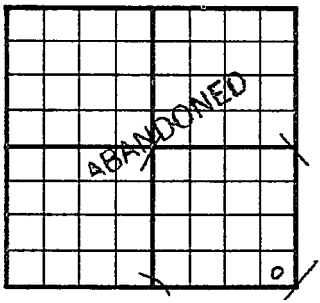

330 Ft. From S Line SE

330 Ft. From E Line Quarter

Ist. Report

Completion OCT 31 1951

Remarks Wildcat

Quaker Drlg. - Contr.

Spudding Date 9-29-51

Drlg. Data D & A TD 3385

8" @ 200 Anhy 675 Heeb. 2939

Br. lime 3047 Lans. 3063 DST 3066-3100

open 1 hr. Rec. 18' mud DST 3239-64

open 45 min. Rec. 125' hocm Cong. 3320

Arb. 3371 5" @ 3379 TD 3385 water

PB 3325 24/ 3260-66 500 A 1½ boph

16/ 3256-60 1000 A S/ 2 boph PB 3080

32/ 3060-68 500 A S/ 50 gw SSO

S/ 3/4 gw 5 hr.

D & A

J. E. TYRA