


KANSAS

Barton

Section 36 Township 17 Range 12W

Well No. #1 W. Stueder

Company Shell

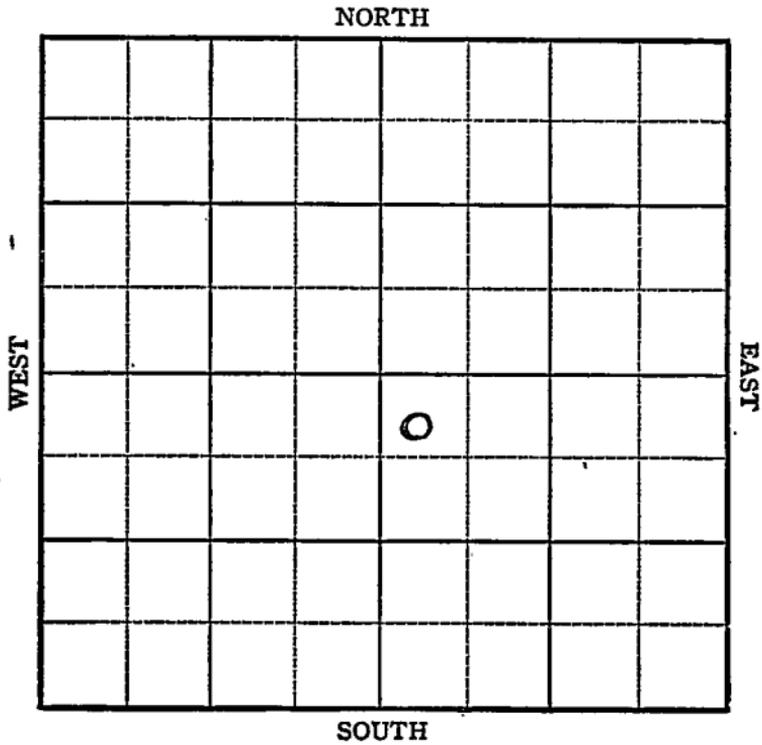

KANSAS

Barton

Sec. 36 Twp. 17 R. 12W

Well No. #1 W. Stueder Farm

Shell Company


Wildcat

480 Ft. from N. Line

_____ Ft. from S. Line

_____ Ft. from E. Line

330 Ft. from W. Line

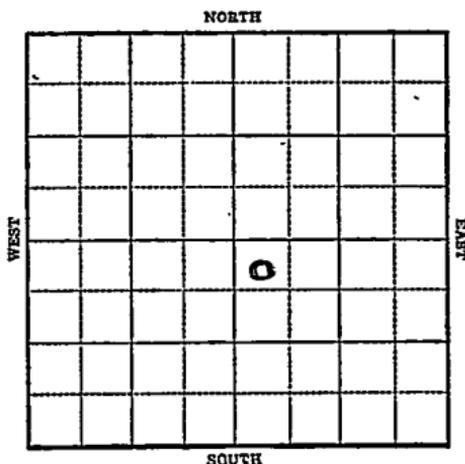

1944

R E P O R T

3/8	Rotary
3/16	8" @ 690 Drilling 1700
3/22	Drig. 2902'
3/29	Topeka 2698 Lans 3045 Cong 3309 Arb 3354 TB 3382 No shows

ABANDONED

KANSAS
 Map No. _____ Sec. 36 Twp. 17 R. 12W

Well No. I W. Stueder

Shell Company

FIRST REPORT Contractor

NW SE

SECTION PLAT

480 Ft. from N. Line

_____ Ft. from S. Line

_____ Ft. from E. Line

330 Ft. from W. Line

		a	

Wild cat

Location _____

Rig up _____

Drilling and Remarks:

Rotary

RECORD

Cased _____ in., _____ ft.

Sand _____

Gas _____

Oil _____

Total Depth _____

PRODUCTION

1st 24 hrs. Nat. _____

1st 24 hrs. after shot _____

Gas _____ Cu. Ft.

Dry Hole _____

Abandoned _____

Date

MAR 8 1944 19

S. J. LEWIS Scout

Barton

Map No. KANSAS Sec. 36 Twp. 17 R. 12W

Well No. I W. Stueder

Shell Company

ABANDONED Contractor

NW SE

SECTION PLAT

480 Ft. from N. Line

_____ Ft. from S. Line

_____ Ft. from E. Line

330 Ft. from W. Line

		o	

Wil deat

Location _____

Rig up _____

Drilling and Remarks:

Top E ka 2698
Lane 3045.
Cong 3309
CE 3354
Noshore

RECORD

Cased _____ in., _____ ft.

Sand _____

Gas _____

Oil _____

Total Depth 3382

PRODUCTION

1st 24 hrs. Nat. _____

1st 24 hrs. after shot 1

Gas _____ Cu. Ft.

Dry Hole _____

Abandoned _____

Date

MAR 29 1944 19

S. J. LEWIS Scout