


KANSAS

Barton county

Section 2 Township 17 Range 13W

Well No. #2, Horst

Company Sohio et al

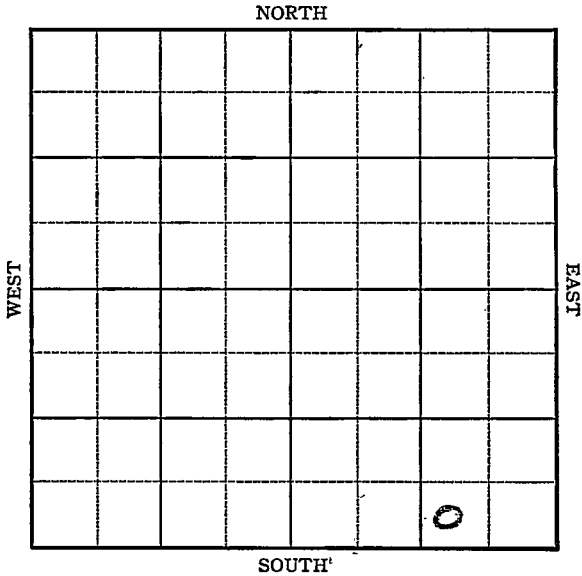

Sec. 2 Twp. 17 R. 13W

Well No. #2 Horst Farm

Sohio et al Company


Susank

_____ Ft. from N. Line

330 Ft. from S. Line

990 Ft. from E. Line

_____ Ft. from W. Line

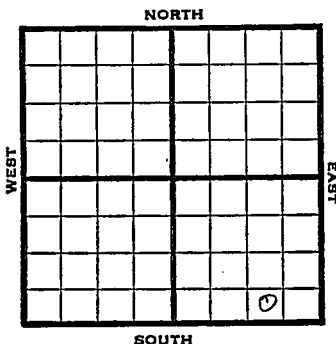

SW SE SE

REPORT

1946 Elev. 1882

5/22 Location
 5/29 8" @ 285' WOC
 6/5 Lans 3115
 Drlg. 3320'
 6/12 Arb 3354
 5" @ 3355
 TD 3357-500 acid
 Swb 2½ oil PH
 6/26 " " "
 7/3 " " "
 7/10 Arb. 3354
 5' @ 3355
 TD 3357
 Pump 101 Pot. plus 8% wtr.
 Grav. 39.0

COMPLETED

Kansas Pool Name Susank

KANSAS

Map No. 73 Sec. 2 Twp. 17 R. 13W

Well No. 2 Horst

Sohio etal Company

FIRST REPORT Contractor

SW SE SE

SECTION PLAT

			D

_____ Ft. from N. Line

330 Ft. from S. Line

990 Ft. from E. Line

_____ Ft. from W. Line

Barton County

Location ✓

Rig up _____

Drilling and Remarks:

RECORD

Cased _____ in., _____ ft.

Sand _____

Gas _____

Oil _____

Total Depth _____

PRODUCTION

1st 24 hrs. Nat. _____

1st 24 hrs. after shot _____

Gas _____ Cu. Ft.

Dry Hole _____

Abandoned _____

Date

MAY 22 1946 19

S. J. LEWIS Scout

KANSAS Kansas Pool Name Susank Pool

Map No. 73 Sec. 2 Twp. 17 R. 13W

Well No. 2 Horst

Sohio etal. Company

COMPLETED

Contractor

SW SE SE

E. 11872

SECTION PLAT

_____ Ft. from N. Line

330 Ft. from S. Line

990 Ft. from E. Line

_____ Ft. from W. Line

Barton County

Location _____

Rig up _____

Drilling and Remarks:

Cor 13354
5' @ 3354
Pump 101 Rt
7 1/2 W

39 9/12

RECORD

Cased _____ in., _____ ft.

Sand _____

Gas _____

Oil _____

Total Depth 3357

PRODUCTION

1st 24 hrs. Nat. _____

1st 24 hrs. after shot _____

Gas _____ Cu. Ft.

Dry Hole _____

Abandoned _____

Date

JUL 10 1946 19

S. J. LEWIS Scout