

KANSAS


FORM 51 5M 6-46 PETROL

Barton County

Section 2 Township 17 Range 13W

Well No. 3 Horst

Company Sohio & Ives

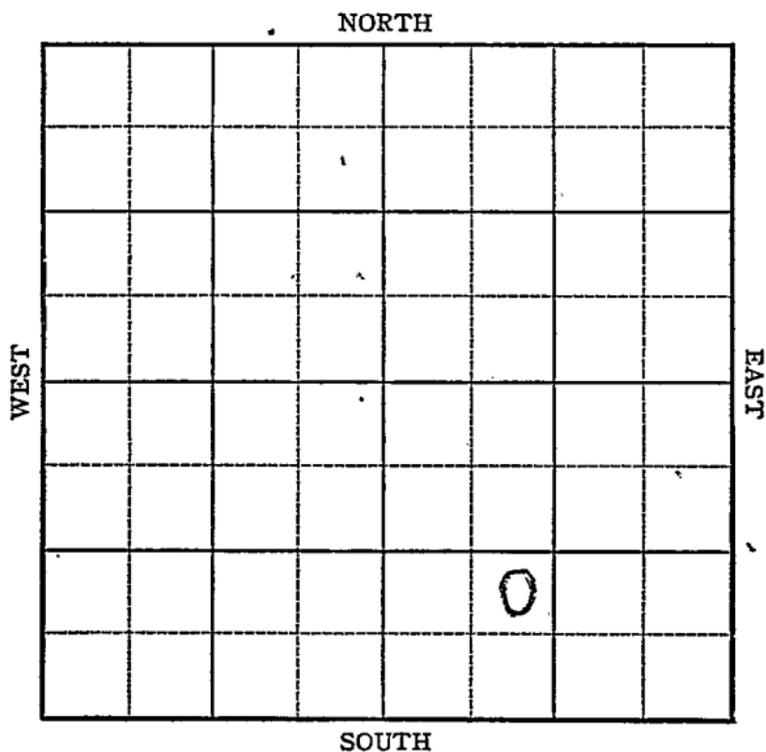

Sec. 2 Twp. 17 R. 13W

Well No. #3 Horst Farm

Sohio & Ives Company

Susank

_____ Ft. from N. Line

990


_____ Ft. from S. Line

_____ Ft. from E. Line

990

_____ Ft. from W. Line

NE SW SE

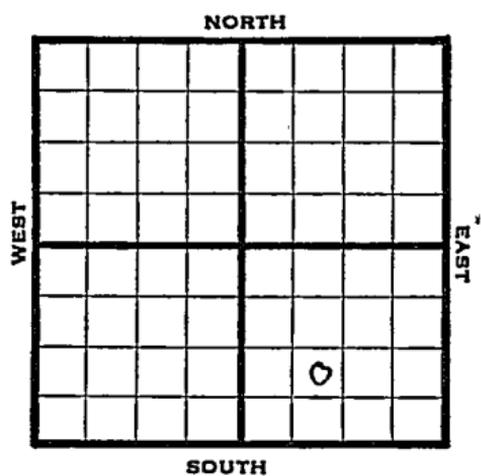

1946 Elev. 1861' REPORT

- 8/7 Location
- 8/13 8" @ 281
Drlg 1105'
- 8/20 Arb 3317-
3320 TD
Run 5"
- 8/27 5" @ 3317
TD 3326
500 acid, swb 18 oil PH 3 hrs
- 9/5 " " "
- 9/10 " " "
- 9/18 Arb 3317'
5" @ 3317'
500 gal acid
TD 3326'
Pump 142 Pot
Grav. 39

COMPLETED

KANSAS

Kansas Pool Name SusankMap No. 73 Sec. 2 Twp. 17 R. 13WWell No. 3 HorstSohio & Ives

Company

FIRST REPORT

Contractor

NE SW SE

SECTION PLAT

		o	

 Ft. from N. Line990 Ft. from S. Line Ft. from E. Line990 Ft. from W. LineBarton CountyLocation XRig up

Drilling and Remarks:

RECORD

Cased in., ft.Sand Gas Oil Total Depth

PRODUCTION

1st 24 hrs. Nat. 1st 24 hrs. after shot Gas Cu. Ft.Dry Hole Abandoned

Date

AUG 7 1946 19S. I. LEWIS Scout

KANSAS

Kansas

Pool Name

Susank Pool

Map No.

73

Sec.

2

Twp.

17

R.

13W

Well No.

3 Horst

Sohio & Ives

Company

COMPLETED

Contractor

NE SW SE

E. 1861

SECTION PLAT

_____ Ft. from N. Line

990

_____ Ft. from S. Line

_____ Ft. from E. Line

990

_____ Ft. from W. Line

		0	

Barton County

Location _____

Rig up _____

Drilling and Remarks:

Cry 3317

5" @ 3317

500 acid

Pump 142 P. X

39 3/4

RECORD

Cased _____ in., _____ ft.

Sand _____

Gas _____

Oil _____

Total Depth 3326

PRODUCTION

1st 24 hrs. Nat. _____

1st 24 hrs. after shot _____

Gas _____ Cu. Ft.

Dry Hole _____

Abandoned _____

Date

SEP 1 8 1946 19

S. J. LEWIS

Scout