

KANSAS


FORM 51 5M 6-46 PETROL

Barton county

Section 2 Township 17 Range 13-W

Well No. #5, Horst

Company Shio

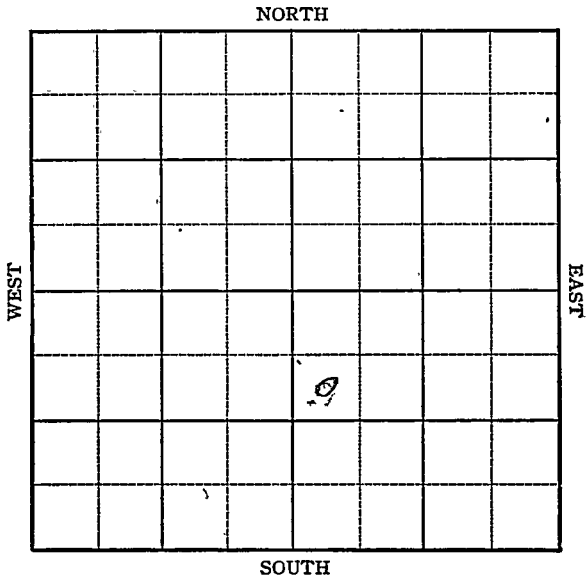

Sec. 2 Twp. 17 R. 13W

Well No. #5 Horst Farm

Sohio Company

Susank


990 Ft. from N. Line

_____ Ft. from S. Line

_____ Ft. from E. Line

330 Ft. from W. Line

SW NW SE

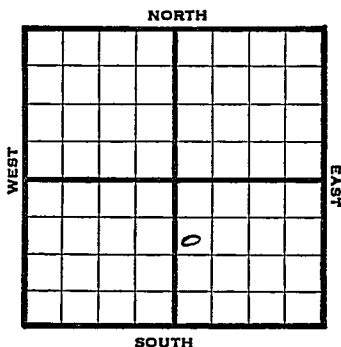

1946 Elev. 1857' REPORT

11/6	8" @ 275'		
	Drlg 2110'		
11/12	Arb 3309-12 TD		
	5" @ 3310, RUST		
11/20	" "		
11/27	TD 3314-1000' acid		
	Swb 25 oil PH		
12/3	" "	"	"
12/10	" "	"	"
12/18	Arb 3309'		
	5" @ 3310'		
	TD 3314'		
	1000 Acid		
	Depth Pot 864		
	37 Grav.		

COMPLETED

Map No. 73 Sec. 2 Twp. 17 R. 13W

Well No. 5 Horst

Sohio Company

FIRST REPORT

Contractor

SW NW SE

SECTION PLAT

990 Ft. from N. Line

_____ Ft. from S. Line

_____ Ft. from E. Line

330 Ft. from W. Line

		a	

Barton County

Location _____

Rig up _____

Drilling and Remarks:

8" @ 275
drlg. 2110

RECORD

Cased _____ in., _____ ft.

Sand _____

Gas _____

Oil _____

Total Depth _____

PRODUCTION

1st 24 hrs. Nat. _____

1st 24 hrs. after shot _____

Gas _____ Cu. Ft.

Dry Hole _____

Abandoned _____

Date

NOV 6 1946 19 _____ S. J. LEWIS Scout

