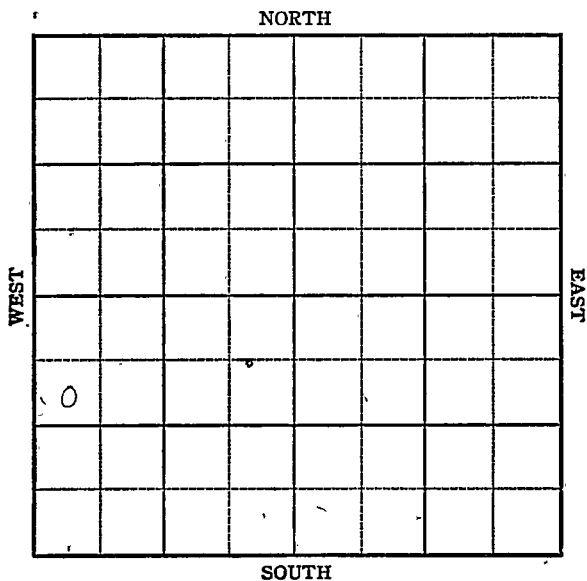


KANSAS

Barton

Section 1 Township 17 Range 13-WWell No. #1 RiefCompany Keys Drlg

KANSAS

Susank Pool ✓

Sec. 1 Twp. 17 R. 13-W

Well No. 1 Rief Farm

Keyes Drlg. Company


SW NW SW

990 Ft. from N. Line

_____ Ft. from S. Line

_____ Ft. from E. Line

330 - Ft. from W. Line

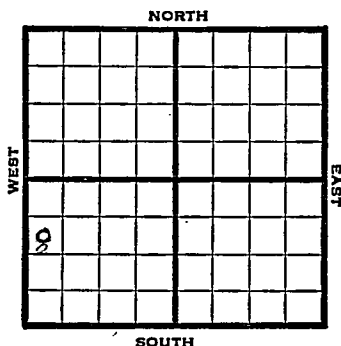

Barton County

1947 1905 REPORT

2-12 R U R .

2/19 8" @ 200'
Anhy 809'
Drlg 2557'

2/26 Lans 3142
Arb 3380
TD 3397'

ABANDONED

KANSAS
Kansas

Susank Pool

Map No. 73 Sec. 1 Twp. 17 R. 13WWell No. 1 RiefKeyes Drlg. CompanyFIRST REPORT Contractor

SW NW SW

SECTION PLAT

990 Ft. from N. Line Ft. from S. Line Ft. from E. Line330 Ft. from W. Line

Barton County

Location Rig up

Drilling and Remarks:

R U R

RECORD

Cased in., ft.Sand Gas Oil Total Depth

PRODUCTION

1st 24 hrs. Nat. 1st 24 hrs. after shot Gas Cu. Ft.Dry Hole Abandoned

Date

FEB 12 1947 19

S. J. LEWIS

Scout

Map No. 73 Sec. 1 Twp. 17 R. 13WWell No. 1 Rief


Keyes Drlg.

Company

ABANDONED

Contractor

SW NW SW

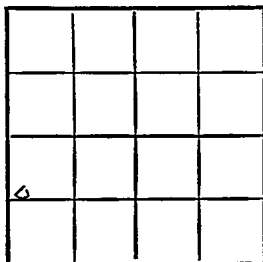E11905
SECTION PLAT990 Ft. from N. Line Ft. from S. Line Ft. from E. Line330 Ft. from W. Line

Barton County

Location Rig up

Drilling and Remarks:

*Lane 3142**Ord 8380*

RECORD

Cased in., ft.Sand Gas Oil Total Depth 2392

PRODUCTION

1st 24 hrs. Nat. 1st 24 hrs. after shot Gas Cu. Ft.Dry Hole Abandoned

Date

FEB 26 1947

19

S. J. LEWIS

Scout