


Section 11 Township 12 Range 15W

Well No. #1 Foster

Company Nadel & Gussman

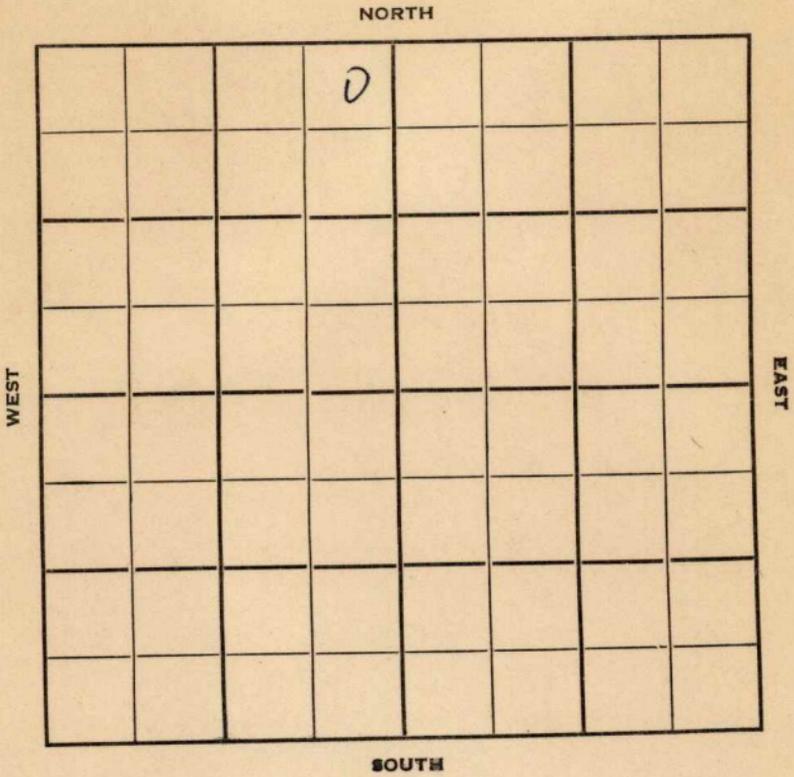

Russell **KANSAS** ✓  
12 R. 15W

Sec. 11 Twp. 12 R. 15W

Well No. #1 Foster Farm  
Nadel & Gussman Company

Fairport Pool


330' Ft. from N. Line

\_\_\_\_\_ Ft. from S. Line

330' Ft. from E. Line

\_\_\_\_\_ Ft. from W. Line

NE NW

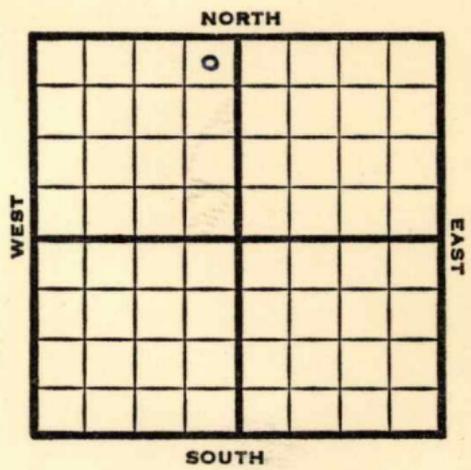

1949

**Elev. 1709'** REPORT

- 11/23 Location
- 11/29 8"@ 420'
- 12/7 Drlg 1757'
- 12/14 **Lans. 2894'**
- Arb. 3204'**
- TD 3229'

**ABANDONED**

Map No. \_\_\_\_\_ Sec. 11 Twp. 12 R. 15W

Well No. 1 Foster

Nadel & Gussman Company

Contractor

FIRST REPORT  
SECTION PLAT

NE NW

		o	

330 Ft. from N. Line

\_\_\_\_\_ Ft. from S. Line

330 Ft. from E. Line

\_\_\_\_\_ Ft. from W. Line

Russell County

RECORD

Location X

Cased \_\_\_\_\_ in., \_\_\_\_\_ ft.

Rig up \_\_\_\_\_

Sand \_\_\_\_\_

Drilling and Remarks:

Gas \_\_\_\_\_

Oil \_\_\_\_\_

Total Depth \_\_\_\_\_

PRODUCTION

1st 24 hrs. Nat. \_\_\_\_\_

1st 24 hrs. after shot \_\_\_\_\_

Gas \_\_\_\_\_ Cu. Ft.

Dry Hole \_\_\_\_\_

Abandoned \_\_\_\_\_

Date

NOV 23 1949 19

S. J. LEWIS Scout

Map No. \_\_\_\_\_ Sec. 11 Twp. 12 R. 15W

Well No. 1 Foster

Nadel & Gussman Company

**ABANDONED** Contractor

NE NW

*E11709*

**SECTION PLAT**

330 Ft. from N. Line

\_\_\_\_\_ Ft. from S. Line

330 Ft. from E. Line

\_\_\_\_\_ Ft. from W. Line


Russell County

Location \_\_\_\_\_

Rig up \_\_\_\_\_

Drilling and Remarks:

*Name 2994*

*On 43204*

**RECORD**

Cased \_\_\_\_\_ in., \_\_\_\_\_ ft.

Sand \_\_\_\_\_

Gas \_\_\_\_\_

Oil \_\_\_\_\_

Total Depth 3229

**PRODUCTION**

1st 24 hrs. Nat. \_\_\_\_\_

1st 24 hrs. after shot \_\_\_\_\_

Gas \_\_\_\_\_ Cu. Ft.

Dry Hole \_\_\_\_\_

Abandoned \_\_\_\_\_

Date

DEC 14 1949 19

S. J. LEWIS Scout