

Form 51-5M-7-39-Palace

Barton


Section 2 Township 17 Range 13-W

Well No. #2 Gage #1

Company Max Cohen et al
Western Kansas Oil & Retail

NORTH

Ainsworth Pool

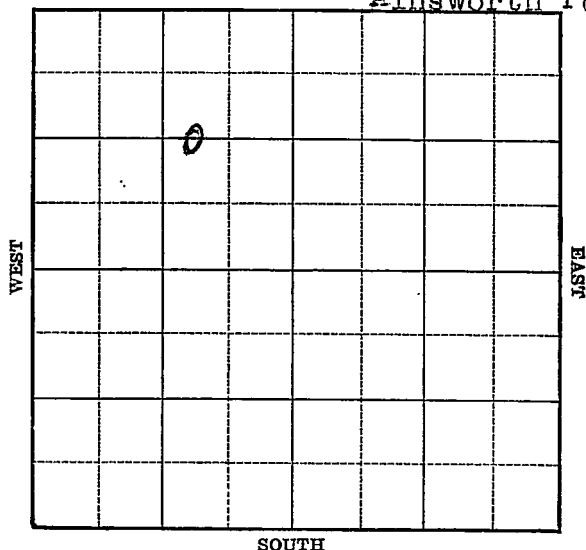

Map No. 73 Sec. 2 Twp. 17 R. 13WWell No. 2 Gage

Western Kansas O & R etal Company

Contractor

FIRST REPORT

C $W\frac{1}{2}$ E $\frac{1}{2}$ NW1320 Ft. from N. Line Ft. from S. Line990 Ft. from E. Line Ft. from W. Line

AINSWORTH POOL

SECTION PLAT

	0		

Location XRig up

Drilling and Remarks:

RECORD

Cased in., ft.Sand Gas Oil Total Depth

PRODUCTION

1st 24 hrs. Nat. 1st 24 hrs. after shot Gas Cu. Ft.Dry Hole Abandoned

Date

NOV 22 1939

19

S. J. LEWIS

Scout

Barton **KANSAS**Map No. 73 Sec. 2 Twp. 17 R. 13WWell No. 1 GageMax Cohen etal


Company

CORRECTION

Contractor

C $W\frac{1}{2}$ E $\frac{1}{2}$ NW1320 Ft. from N. Line Ft. from S. Line990 Ft. from E. Line Ft. from W. Line

SECTION PLAT

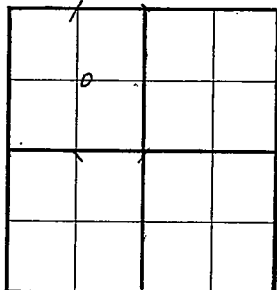

AINSWORTH POOL

Location Rig up

Drilling and Remarks:

Reported as:

Western Kans. O&G.

#2 Gage

RECORD

Cased in., ft.Sand Gas Oil Total Depth

PRODUCTION

1st 24 hrs. Nat. 1st 24 hrs. after shot Gas Cu. Ft.Dry Hole Abandoned

Date

1030 19

S. J. LEWIS

Scout

Barton

KANSASMap No. 73 Sec. 2 Twp. 17 R. 13WWell No. 1 GageMax Cohen et al


Company

Contractor

ABANDONED

C $W\frac{1}{2}$ E $\frac{1}{2}$ NW1320 Ft. from N. Line Ft. from S. Line990 Ft. from E. Line Ft. from W. Line

SECTION PLAT

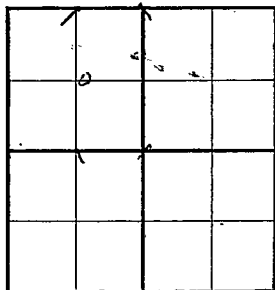

AINSWORTH POOL

Location Rig up

Drilling and Remarks:

*Oil 83338.**No shows*

RECORD

Cased in., 5 ft.Sand Gas Oil Total Depth 3358

PRODUCTION

1st 24 hrs. Nat. 1st 24 hrs. after shot Gas Cu. Ft.Dry Hole Abandoned

Date

DEC 27 1939₁₉

S. J. LEVINS Scout