


FORM 51' 5M 11-44 PETROL

Section 2 Township 17 Range 13W

Well No. #2 Gage 1

Company Max Cohen

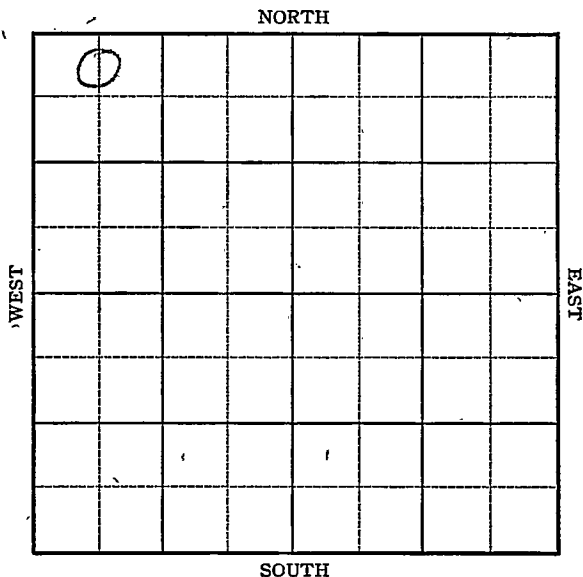

KANSAS

Barton County

Sec. 2 Twp. 17 R. 13W

Well No. #2 Gage Farm

Max Cohen Company

Susank


330 Ft. from N. Line

_____ Ft. from S. Line

_____ Ft. from E. Line

660 Ft. from W. Line

CNL NW NW

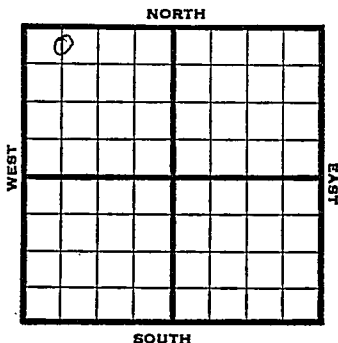

1946 Elev. 1885' REPORT

2/13 Spud
Was Western Kans lease

2/21 Drlg. 2870'

2/28 8" - 270' Topeka 2716'
Lans. 3092' Arb. 3326-28' T.D.
5" - 3326' RUST.

3/7 T.D. 3344' 1500 acid.
1200' oil in 8 hours.

3/14 " " "

3/20 Arb. 3326
5" @ 3326
TD 3344'
1500 acid.
Pump 79 Pot.
Grav. 33.0

COMPLETED

KANSAS Kansas Pool Name SusankMap No. 73 Sec. 2 Twp. 17 R. 13WWell No. 2 GageMax Cohen CompanyFIRST REPORT Contractor

C N L NW NW

SECTION PLAT

0			

330 Ft. from N. Line Ft. from S. Line Ft. from E. Line660 Ft. from W. Line

Barton County

Location Rig up

Drilling and Remarks:

spud

was Western Kans
lease

RECORD

Cased in., ft.Sand Gas Oil Total Depth

PRODUCTION

1st 24 hrs. Nat. 1st 24 hrs. after shot Gas Cu. Ft.Dry Hole Abandoned

Date

FEB 13 1946 19S. J. LEWIS Scout

Kansas Pool Name Susank

KANSAS
 Map No. 13 Sec. 2 Twp. 17 R. 13W

Well No. 2 Gage

Max Cohen Company

COMPLETED

Contractor

E11883

C N L NW NW

SECTION PLAT

330 Ft. from N. Line Ft. from S. Line Ft. from E. Line660 Ft. from W. Line

2			

Barton County

Location

Rig up

Drilling and Remarks:

Per 83326
5' 03326
1500 rods
Pay 79 1/2

33 1/2 Gr

RECORD

Cased in., ft.Sand Gas Oil Total Depth 3344

PRODUCTION

1st 24 hrs. Nat. 1st 24 hrs. after shot Gas Cu. Ft.Dry Hole Abandoned

Date

MAR 20 1946

19

S. J. LEWIS

Scout