

Company Aladdin Pet

Hoisington Pool
NORTH

A 10x10 grid with the following labels:

- Left side: WEST
- Right side: EAST
- Bottom: SOUTH

A small circle is located in the top-left cell of the grid.

KANSAS

Barton

13W ✓

Sec. 2 Twp. 17 R. 13W

Well No. #3-Gage Farm

Aladdin Pet.

Company

Hoisington Pool


850' Ft. from N. Line

Ft. from S. Line

Ft. from E. Line

900' Ft. from W. Line

SE NW NW

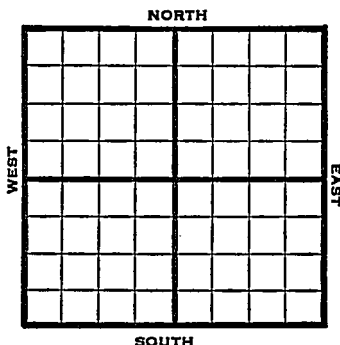

1948

Elev. 1874'

REPORT

10/27

8" @ 135'

Quartzite 3316'

TD 3333'

D&A

TD 3333'

FIRST REPORT

↓
ABANDONED

Kansas

Map No. 73 Sec. 2 Twp. 17 R. 13WWell No. 3 Gage

Aladdin Pet. Company

FIRST REPORT


Contractor

SE NW NW

ABANDONED

E 1 1974

SECTION PLAT

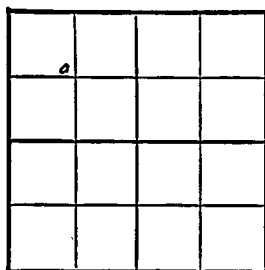850 Ft. from N. Line Ft. from S. Line Ft. from E. Line900 Ft. from W. Line

Barton County

Location

Rig up

Drilling and Remarks:

8" @ 135

Quartzite 3316

TD 3333

D & A

RECORD

Cased in., ft.Sand Gas Oil Total Depth 3333

PRODUCTION

1st 24 hrs. Nat. 1st 24 hrs. after shot Gas Cu. Ft.Dry Hole Abandoned

Date

OCT 27 1948

19

S. J. LEWIS

Scout