


Russell

KANSAS

SECTION 14 TOWNSHIP 12 RANGE 15W

WELL NO. #1 Brandt

COMPANY Globe Oil Co.

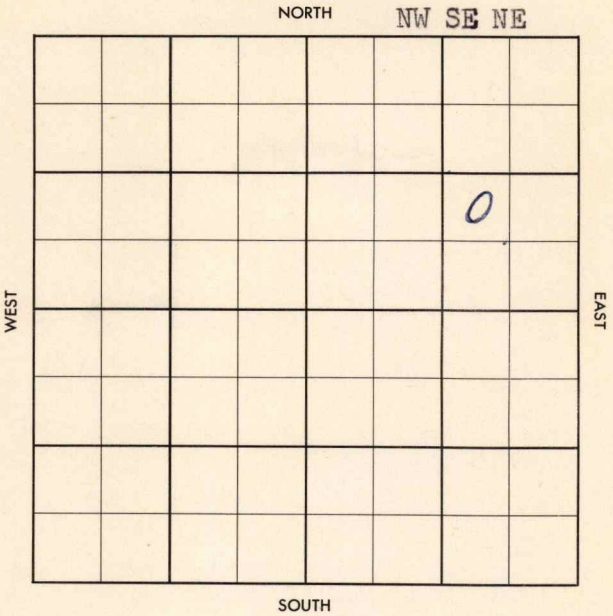

# WILDCAT

FORM 513 SUNRAY

County Russell

Elev. \_\_\_\_\_

Sec. 14

Twp. 12

Rge. 15W

Company Globe Oil Co.

Farm Name Brandt

No. 1

TOPS

DEPTH

LOG

DATUM

Loc. in Sec. \_\_\_\_\_

Anh. \_\_\_\_\_

Tr. \_\_\_\_\_

H. \_\_\_\_\_

Dg. \_\_\_\_\_

Bl. \_\_\_\_\_

L. \_\_\_\_\_

K.C. \_\_\_\_\_

B.K.C. \_\_\_\_\_

Ce. \_\_\_\_\_

C. \_\_\_\_\_

M. \_\_\_\_\_

M. \_\_\_\_\_

K. \_\_\_\_\_

Mz. \_\_\_\_\_

Me. \_\_\_\_\_

V. \_\_\_\_\_

S. \_\_\_\_\_

S. \_\_\_\_\_

A. \_\_\_\_\_

R. \_\_\_\_\_

PE. \_\_\_\_\_

G. \_\_\_\_\_

T.D. \_\_\_\_\_

NW SE NE

Geol. \_\_\_\_\_

Contr. \_\_\_\_\_

Sterling Drlg

Pool

Wildcat

FIRST REPORT

JUN 26 1957

Date Comm. 6-24-57

Drlg. 60

14

Co.

Use

No.

Sec.

T.

R.

County Russell Elev. 1737 KB  
 Sec. 14 Twp. 12 Rge. 15W  
 Company Globe Oil Co.  
 Farm Name Brandt No. 1

TOPS	DEPTH	LOG	DATUM	Loc. in Sec.
Anh.	800			NW SE NE
Tp.	2636			
H.	2852			
Tr.	2873			
Dg.				
BL.				
L.	2905			Geol.
K.C.				Contr.
B.K.C.				Sterling Drl
Ce.				
C.	3193			Pool
M.				Wildcat
M.				
K.				
Mz.				
Mq.				
V.				
S.				
S.				
A.	3214			
R.				
PE.				
G.				
T.D.	3266			ABANDONED

Pool  
Wildcat



ABANDONED

Date Comm. 6-24-57  
 Drlg. 60 JUL 3 '57 878 358 DST  
2903-17 1hr rec 20' MSW  
+ Rainbow show 55/30 MD 2925  
JUL 10 '57 DST 2995-3015 1hr  
210' gip rec 50' HO & GCM  
+ 80' oily SW BHP 875/30"  
DST 3087-3105 35" rec 13'  
MD BHP 560/30 DST 3220-28  
1hr rec 11' MD BHP 0 P&A