


DX 78-1

Russell

KANSAS

Section 17 Township 12S Range 15W
Well No. #1 Holland
Company Shields Oil Prod.

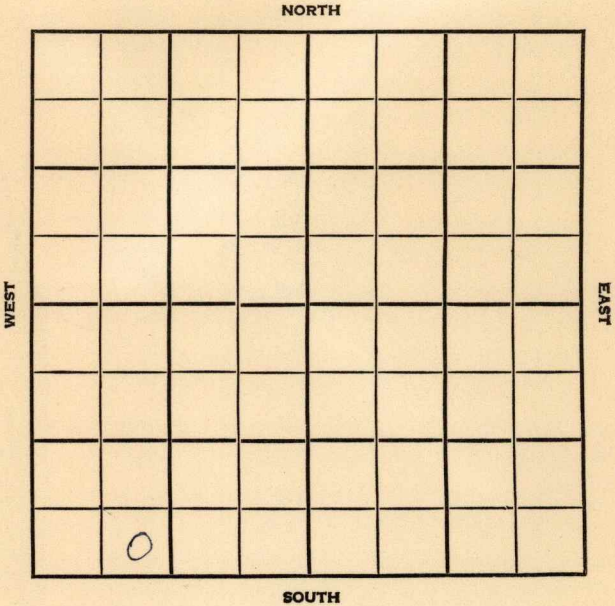

County Russell Elev. _____
 Sec. 17 Twp. 12S Rge. 15W
 Company Shields Oil Prod.
 Farm Name Holland No. 1

TOPS	DEPTH	LOG	DATUM	Loc. in Sec.
Anh.				SE SW SW
TP.				
H.				
Tr.				
Dg.				
Bl.				
L.				Geol. _____
K.C.				Contr. _____
B.K.C.				Co. _____
Ce.				
C.				
M.				
M.				Pool _____
K.				Fairport
Mz.				
Me.				
V.				
S.				
S.				
A.				
R.				
PE.				
G.				
T.D.				

Date Comm. FIRST REPORT
MIRT OCT 10 '56

OCT 5 + 1956

R.G.

Co.
Lse.
No.
Sec.
T.
R.

County Russell Elev. 1850 RB
 Sec. 17 Twp. 12S Rge. 15W
 Company Shields Oil Prod.
 Farm Name Holland No. 1

TOPS	DEPTH	LOG	DATUM	Loc. in Sec.									
Anh.				SE SW SW									
Tp.	2706												
H.	2924												
Tr.	2943												
Dg.													
Bl.													
L.	2978			Geol.									
K.C.				Contr.									
B.K.C.				Co.									
C.	Gothsd 3260			Pool									
M.				Fairport									
M.				<table border="1"> <tr> <td colspan="3">COMPLETE</td> </tr> <tr> <td></td> <td>OCT 31 '56</td> <td></td> </tr> <tr> <td></td> <td></td> <td></td> </tr> </table>	COMPLETE				OCT 31 '56				
COMPLETE													
	OCT 31 '56												
K.													
Mz.													
Mo.													
V.													
S.													
S.													
A.													
R.													
PE.													
G.													
T.D.	3266												

Date Comm. MIRT OCT 17 '56 10-11-56 8 7/8 900
1425 @ 2840 OCT 24 '56
5 7/8 @ 3262/200 OCT 31 '56 CO 3266
8 7 Boph 5 hrs P&P
P. 25 Boph w/ol wt.

Co.

Loc.

No.

Sec.

T.

R.