


Section 2 Township 17 Range 13-W

Well No. 1 Lowry

Company Texas

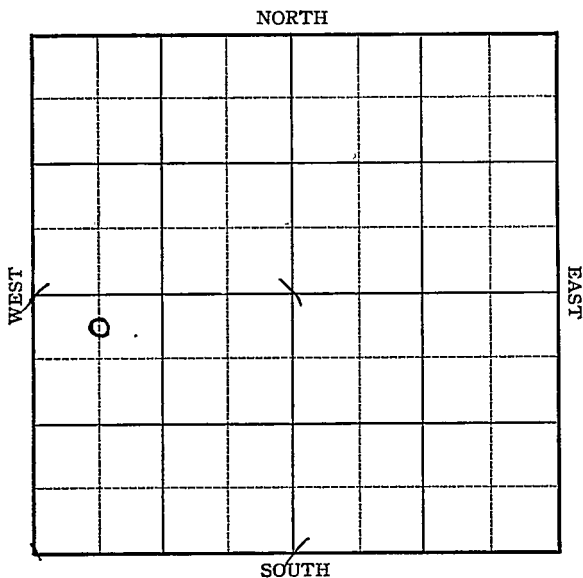


Sec. 2 Twp. 17 R. 13-WWell No. #1 Lowry FarmTexas Company330 Ft. from N. Line

_____ Ft. from S. Line

_____ Ft. from E. Line

660 Ft. from W. Line

Elev. 1865'

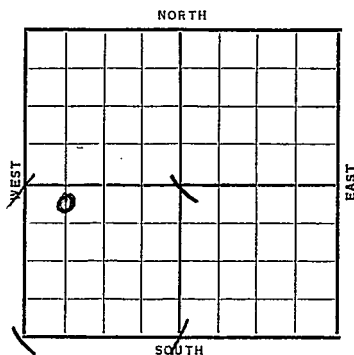

Date	REPORT
1938	
1/19	Location
1/28	12"- 200' Drlg. 730'.
2/4	Top Kansas City 3074'.
	Small show of oil 3092-95'.
	Drlg. 3100'. (Tel)
2/4	Anhy 758' Fort Riley 1750'
	Drlg. 2605' (Drilling Report)
2/4	Top Kansas City 3074'
	Small show of oil 3092-95'.
	Drlg. 3100'. (Tel)
2/11	Topeka 2670'. - Base Oriad 3010
	K. C. 3085 (Corrected)
	Shows of oil 3081-84 & 3126-29
	& 3234-44' I
	Arb. & 7" @ 3323'.
	T.D. 3324'. S.O. RUST.
2/18	Arb. 3325' & 7" (Corrected)
	Sm. S.O. 3330-40'.
	Inc. 3340-42' T.D. 150' oil
	in 7 hrs. 1000 acid.

OVER

1938

2//26 2000 acid. Pumped 8 bbls. oil
in 7 hrs.

3/2

7" @ 3325'.
Arb. 3325'.
T.D. 3362'.
3000 acid (Total).
750' fluid 14 hrs.
75% water.

ABANDONED

Map No. 73 Sec. 2 Twp. 17 R. 13WWell No. 1 LowryTexas

Company _____

Contractor _____


FIRST REPORT

C N L NW SW

SECTION PLAT330 Ft. from N. Line

_____ Ft. from S. Line

_____ Ft. from E. Line

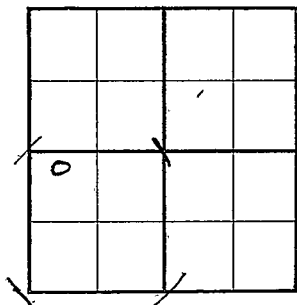660 Ft. from W. LineLocation X

Rig up _____

Drilling and Remarks: _____

RECORD

Cased _____ in., _____ ft.

Sand _____

Gas _____

Oil _____

Total Depth _____

PRODUCTION

1st 24 hrs. Nat. _____

1st 24 hrs. after shot _____

Gas _____ Cu. Ft.

Dry Hole _____

Abandoned _____

Date

JAN 19 1938 19H. D. Hatfield Scout

Barton KANSAS

Map No. _____ Sec. 2 Twp. 17 R. 13WWell No. 1 LowryTexas

Company _____

Contractor _____

ABANDONED

C N L NW SW

330 Ft. from N. Line

_____ Ft. from S. Line

_____ Ft. from E. Line

660 Ft. from W. Line

SECTION PLAT

①			

Location _____

Rig up _____

Drilling and Remarks:

2000 Acid (Total)750' Fluid - 14 hr75' 90 wtrD & A

RECORD

Cased 7 in. 3325 ft.Sand Arb 3325

Gas _____

Oil _____

Total Depth 3362

PRODUCTION

1st 24 hrs. Nat. _____

1st 24 hrs. after shot _____

Gas _____ Cu. Ft.

Dry Hole _____

Abandoned _____

Date

MAR 2 - 1938

19

H. D. Hatfield Scout