


Form 51 5M 11-23 13890  
Map No. Russell

Sec. 17 Twp. 12 R. 15<sup>u</sup>

Well No. 1. Russell Farm  
Valerus Blue Company

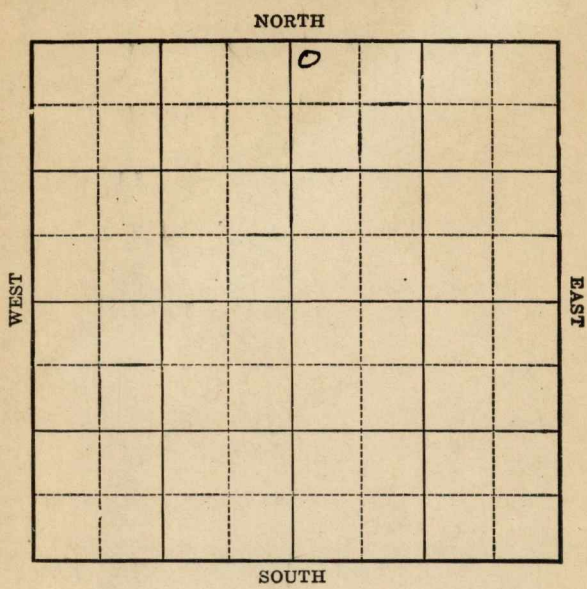

Location \_\_\_\_\_

Drilling Remarks:

\_\_\_\_\_

\_\_\_\_\_

RECORD

Cased \_\_\_\_\_ in. \_\_\_\_\_ ft.

Sand \_\_\_\_\_

Gas \_\_\_\_\_

Oil \_\_\_\_\_

Total Depth \_\_\_\_\_

Rig Up \_\_\_\_\_

Drilling Remarks:

\_\_\_\_\_

\_\_\_\_\_

PRODUCTION

1st 24 hrs. Nat. \_\_\_\_\_

1st 24 hrs. after shot \_\_\_\_\_

Gas \_\_\_\_\_ cu. ft.


Dry Hole \_\_\_\_\_

Abandoned \_\_\_\_\_

Map No. 15 Sec. 17 Twp. 12 R. 15 <sup>W</sup>Well No. 1-Mussel FarmValerius et al Company200 Ft. from N. Line

Ft. from S. Line

Ft. from E. Line

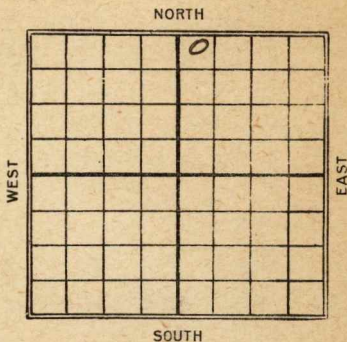200 Ft. from W. Line

Date

REPORT

4/9 Regridded up

5/10 10" - 1560

8'4 - 2160

DL9 2210

11/23 Line Pay 2997-3037

Pumping 135 Bbls not

per day

Map No. *10 Map* Sec. *17* Twp. *12 N* R. *15 W*Well No. *#1 Russell**Valerius et al.* Company

Contractor

## FIRST REPORT

## SECTION PLAT

*200'* Ft. from N. Line

\_\_\_\_\_ Ft. from S. Line

*200'* Ft. from E. Line*200* Ft. from W. Line

|  |  |          |  |
|--|--|----------|--|
|  |  | <i>0</i> |  |
|  |  |          |  |
|  |  |          |  |
|  |  |          |  |

Location \_\_\_\_\_

Rig up \_\_\_\_\_

Drilling and Remarks:

*Rigged up*

## RECORD

Cased \_\_\_\_\_ in., \_\_\_\_\_ ft.

Sand \_\_\_\_\_

Gas \_\_\_\_\_

Oil \_\_\_\_\_

Total Depth \_\_\_\_\_

## PRODUCTION

1st 24 hrs. Nat. \_\_\_\_\_

1st 24 hrs. after shot \_\_\_\_\_

Gas \_\_\_\_\_ Cu. Ft.

Dry Hole \_\_\_\_\_

Abandoned \_\_\_\_\_

Date

APR 9 1924

192

M. A. BENEAR

Scout

**KANSAS**Map No. \_\_\_\_\_ Sec. 17 Twp. 12 R. 15WWell No. 1 RussellValerius Oil Company

Contractor \_\_\_\_\_

**COMPLETED****SECTION PLAT**200 Ft. from N. Line

\_\_\_\_\_ Ft. from S. Line

\_\_\_\_\_ Ft. from E. Line

200 Ft. from W. Line

|  |  |   |  |
|--|--|---|--|
|  |  | 0 |  |
|  |  |   |  |
|  |  |   |  |
|  |  |   |  |
|  |  |   |  |

Location \_\_\_\_\_

Rig up \_\_\_\_\_

Drilling and Remarks:

Line Day2997-3037pumping 135 lbsnet per day**RECORD**

Cased \_\_\_\_\_ in., \_\_\_\_\_ ft.

Sand \_\_\_\_\_

Gas \_\_\_\_\_

Oil \_\_\_\_\_

Total Depth \_\_\_\_\_

**PRODUCTION**

1st 24 hrs. Nat. \_\_\_\_\_

1st 24 hrs. after shot \_\_\_\_\_

Gas \_\_\_\_\_ Cu. Ft.

Dry Hole \_\_\_\_\_

Abandoned \_\_\_\_\_

Date

NOV 23 1924

M. A. BENEAR

192

Scout