


KANSAS

Section 2 Township 17 Range 13-WWell No. #10 Lowry "B"Company Aladdin Pet.

NORTH

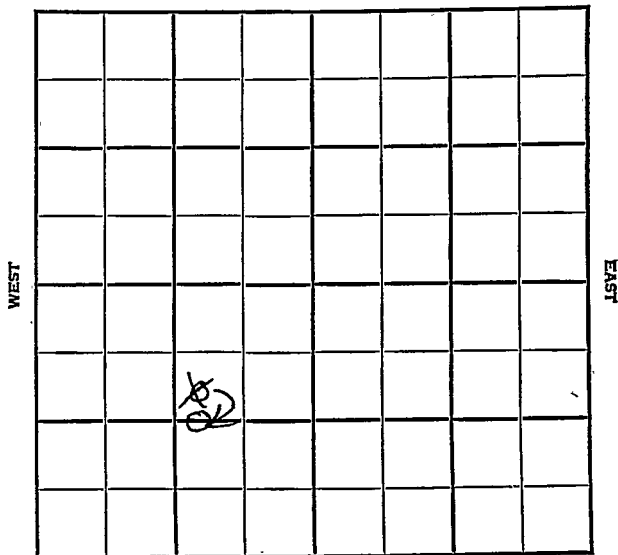

SOUTH

KANSAS Barton

Sec. 2 Twp. 17 R. 13W

Well No. #10 Lowry "B" Farm

Aladdin Pet. Company

Ainsworth Pool


990' Ft. from N. Line

1255' Ft. from S. Line

990' Ft. from E. Line

Ft. from W. Line

~~SW NE SW~~
CWL Ek SW

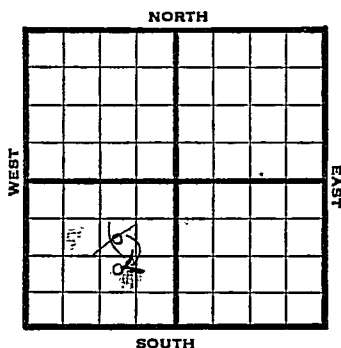

1948

Elev. 1856' REPORT

6/16 Location

6/23 8" @ 168
Drlg 1690'

6/29 Lansing 3069'
Arbuckle 3316'
TD 3318'
5" @ 3317'
RUST

7/8 "

7/14 TD 3320 500 acid
Swb $3\frac{1}{2}$ bbls oil RH

7/21 " "

7/28 " "

8/4 "

8/11 Arbuckle 3316'
5" @ 3317'
TD 3320'
Pump 109 bbls oil Pot.
Gr. 39°

COMPLETED

Map No. _____ Sec. 2 Twp. 17 R. 13W

Well No. 10 Lowry "B"

Aladdin Pet. Company

FIRST REPORT

Contractor

SW NE SW


SECTION PLAT

990 Ft. from N. Line

_____ Ft. from S. Line

990 Ft. from E. Line

_____ Ft. from W. Line

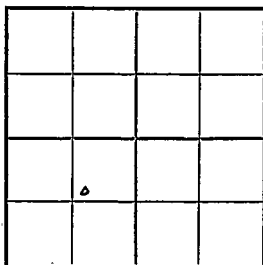

Barton County

Location X

Rig up _____

Drilling and Remarks:

RECORD

Cased 2 1/2 in. 251 ft.

Sand _____

Gas _____

Oil _____

Total Depth 251

PRODUCTION

1st 24 hrs. Nat. _____

1st 24 hrs. after shot _____

Gas _____ Cu. Ft.

Dry Hole _____

Abandoned _____

Date

JUN 16 1948 19 S. J. LEWIS Scout

Map No. 73 Sec. 2 Twp. 17 R. 13WWell No. 10 Lowry "B"

Aladdin Pet.


Company

CORRECTION

Contractor

C W L E $\frac{1}{2}$ SW

SECTION PLAT

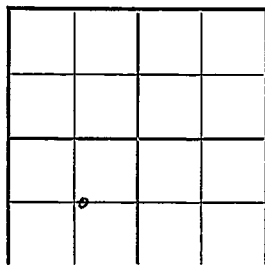

_____ Ft. from N. Line

1255 Ft. from S. Line990 Ft. from E. Line

_____ Ft. from W. Line

Barton County

Location _____

Rig up _____

Drilling and Remarks:

Reported

SW NE SW

RECORD

Cased _____ in., _____ ft.

Sand _____

Gas _____

Oil _____

Total Depth _____

PRODUCTION

1st 24 hrs. Nat. _____

1st 24 hrs. after shot _____

Gas _____ Cu. Ft.

Dry Hole _____

Abandoned _____

Date


JUN 30 1948 19 S. J. LEWIS Scout

Barton County Kansas StateMap No. 73 Sec. 2 Twp. 17 R. 13WWell No. 10 Lowry "B"Aladdin Pet. Company**COMPLETE**

Contractor

C W L E $\frac{1}{2}$ SWE11/856

SECTION PLAT

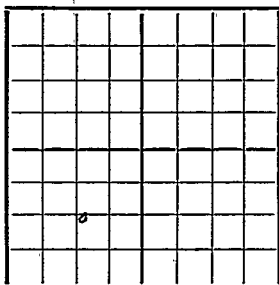 Ft. from N. Line1255 Ft. from S. Line990 Ft. from E. Line Ft. from W. LineAinsworth Pool

Remarks:

AR 433165" @ 3317YD 3320Pump 109 ft oil pool29° Se

Date

AUG 11 1948

Scout

S. J. LEWIS