

Barton


FORM 51 IOM 12-46 PETROL

KANSAS

Section 2 Township 17 Range 13W

Well No. 5 Lowry "B"

Company Alladin et al

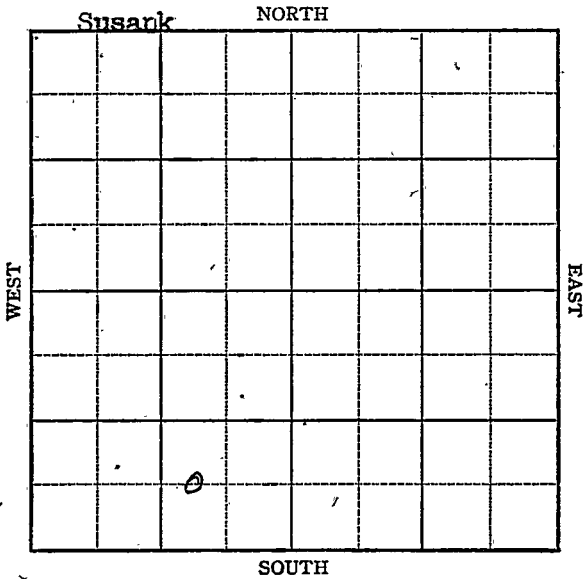

Sec. 2 Twp. 17S R. 13W

Well No. 5 Lowry "B" Farm
Alladin et al. Company


Susank Pool

 Ft. from N. Line

660 Ft. from S. Line

990 Ft. from E. Line

~~990~~ Ft. from W. Line

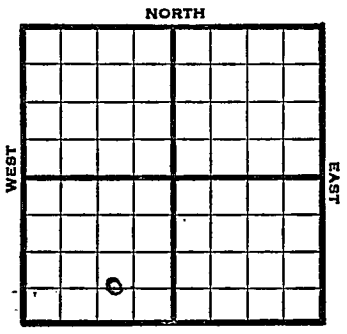

C W L SE SW Elev. 1855'

1947		REPORT		
3/26	8" @ 160'			
	Drlg. 1520'.			
4/2				
	Drlg. 3060'.			
4/9	Arb 3315'			
	TD 3317'			
	5" @ 3315'			
	RUST			
4/15	TD 3318'			
	Swb. 10 bbls. oil PH			
4/23	"	"	"	
4/29	"	"	"	
5/7	"	"	"	
5/13	"	" 4	"	
5/20	"	"	"	

OVER

5/28

Arb 3315
5" @ 3315
500 Acid
Pump 616 Pot
Grav. 36.9
TD 3318'

COMPLETED

Map No. 73 Sec. 2 Twp. 17 R. 13W

Well No. 5 Lowry "B"

Alladin etal. Company

FIRST REPORT Contractor

C W L SE SW

SECTION PLAT

_____ Ft. from N. Line
660 Ft. from S. Line
990 Ft. from E. Line
 _____ Ft. from W. Line

Barton County

Location _____

Rig up _____

Drilling and Remarks:

8" @ 160

drlg. 1520

RECORD

Cased _____ in., _____ ft.

Sand _____

Gas _____

Oil _____

Total Depth _____

PRODUCTION

1st 24 hrs. Nat. _____

1st 24 hrs. after shot _____

Gas _____ Cu. Ft.

Dry Hole _____

Abandoned _____

Date

MAR 26 1947 19

S. J. LEWIS Scout

Map No. K73 Sec. 2 Twp. 17 R. 13^W

Well No. 5 Lowry "B"

Aladdin etal. Company

COMPLETE

Contractor

C W L SE SW

E1.1805
SECTION PLAT

 Ft. from N. Line

660 Ft. from S. Line

990 Ft. from E. Line

 Ft. from W. Line

	0		

Barton County

Location

Rig up

Drilling and Remarks:

Per 3315
5" @ 3315
500 acid
Pump 6/6 BT

36 2/3

RECORD

Cased in., ft.

Sand

Gas

Oil

Total Depth 3315

PRODUCTION

1st 24 hrs. Nat.

1st 24 hrs. after shot

Gas Cu. Ft.

Dry Hole

Abandoned

Date

MAY 28 1947 19 S. J. LEWIS Scout