


Section 17 Township 12 Range 15W

Well No. #2 Holland

Company Shields Oil Prod.

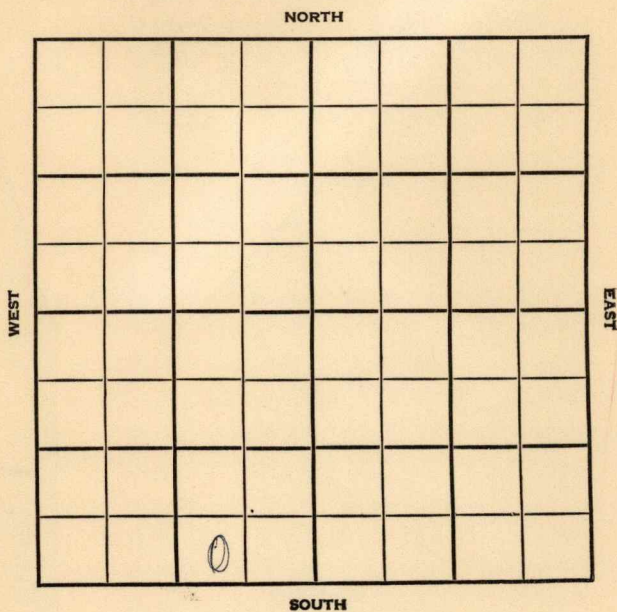

Co.

County Russell Elev. 1841
 Sec. 17 Twp. 12 Rge. 15W
 Company Shields Oil Prod.
 Farm Name Holland No. 2

TOPS	DEPTH	LOG	DATUM	Loc. in Sec.
Anh.	884			SW SE SW
Tp.	2713			
H.	2934			
Tr.	2954			
Dg.				
Bl.				
L.	2986			Geol.
K.C.				Contr.
B.K.C.				Co. tools
Ce.				
C.				
M.				Pool
M.				
K.				Fairport
Mz.	Gorksd 3270			
Mo.				
V.				
S.				
S.				
A.	3331			ABANDONED
R.	3460			
PE.				
G.	wh 3505			
TD.	3535			JAN 30 '57

Loc.

No.

Sec.

T.

R.

Date Comm. 11-20-56 NOV 28 '56
 R I R 878 895/400
DST 2885-2920 30" rec 85'
MW BHP 820 DST 2975-40-70
1hr rec 60' gas + 20' oil 6CM
BHP 180 ID 3024 DEC 5 '56 DST
2988-3000 40" 35' MW FPO-0
BHP 160/20" DST 3254-72 op
15" rec 20' Md BHP 150/20" DST
3272-80 30" 15' Md FPO-0

BHP 920/20 5 1/2 3335/

DEC 12 '56

DEC 19 '56

WOOD

DEC 26 '56

CO

hole in csg 56d. JAN 2 '57

JAN 9 '57

JAN 16 '57

TUFF


JAN 23 '57

JAN 30 '57

CO 3535 TD 12

input 300 Bwph


comp. for SWD well.

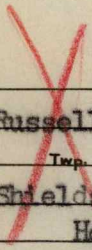

County Russell Elev. _____
 Sec. 17 Twp. 12 Rge. 15W
 Company Shields Oil Prod.
 Farm Name Holland No. 2

TOPS	DEPTH	LOG	DATUM	Loc. in Sec.												
Anh.				SW SE SW												
Tp.																
H.																
Tr.																
Dg.																
Bl.																
L.				Geol. _____												
K.C.				Contr. _____												
B.K.C.				Co. tools												
Ce.																
C.				Pool												
M.				Fairport												
M.				<table border="1"> <tr> <td></td> <td></td> <td></td> </tr> <tr> <td></td> <td>NOV 21 1956</td> <td></td> </tr> <tr> <td>FIRST REPORT</td> <td></td> <td></td> </tr> <tr> <td></td> <td></td> <td></td> </tr> </table>					NOV 21 1956		FIRST REPORT					
	NOV 21 1956															
FIRST REPORT																
K.																
Mz.																
Me.																
V.																
S.																
S.																
A.																
R.																
Pe.																
G.																
T.D.																

Date Comm. 11-20-56
RUR

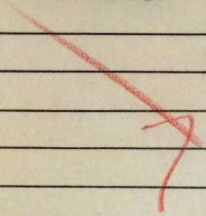

Lse.
No.
Sec.
T.
R.