


Section 3 Township 17 Range 13-W

Well No. 1 Linsner

Company Skelly

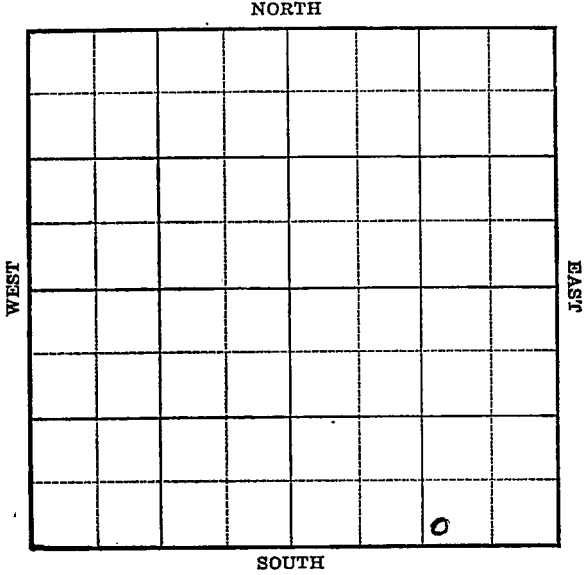

1939

1/27

Deepened to 3418'.

2 bbls. fluid per hour.

20% oil & 80% water.

2/1

7" - 3388'.

Arb. 3387'.

T. D. 3418'.

4575' acid.

S. O. & W.

ABANDONED

Map No. 73 Sec. 3 Twp. 17 R. 13W

Well No. 1 Linsner

Skelly Company

Contractor

FIRST REPORT

SW SE SE

_____ Ft. from N. Line

330 Ft. from S. Line

990 Ft. from E. Line

_____ Ft. from W. Line

SECTION PLAT

Location _____

Rig up _____

Drilling and Remarks:

Matl.

RECORD

Cased _____ in., _____ ft.

Sand _____

Gas _____

Oil _____

Total Depth _____

PRODUCTION

1st 24 hrs. Nat. _____

1st 24 hrs. after shot _____

Gas _____ Cu. Ft.

Dry Hole _____

Abandoned _____

Date

NOV 16 1936 19

D. Hatfield Scout

Barton KANSAS

Map No. _____ Sec. 3 Twp. 17 R. 13WWell No. 1 LinsnerSkelly

Company

Contractor

ABANDONED

SECTION PLAT

SW SE SE

_____ Ft. from N. Line

330 Ft. from S. Line990 Ft. from E. Line

_____ Ft. from W. Line

			0

AINSWORTH POOL

Location _____

Rig up _____

Drilling and Remarks:

4575 AcidS.O. & WD.F.A.

RECORD

Cased 7 in., 3388 ft.Sand Arb 3387

Gas _____

Oil 3418Total Depth ~~3398~~

PRODUCTION

1st 24 hrs. Nat. _____

1st 24 hrs. after shot _____

Gas _____ Cu. Ft.

Dry Hole _____

Abandoned _____

Date

FEB 1 - 1939 19H. D. Hatfield Scout