




Russell

Map No. Kansas Sec. 17 Twp. 12 R. 15<sup>W</sup>

Well No. 4 Oswald Farm

Valerus O + G Company

NORTH

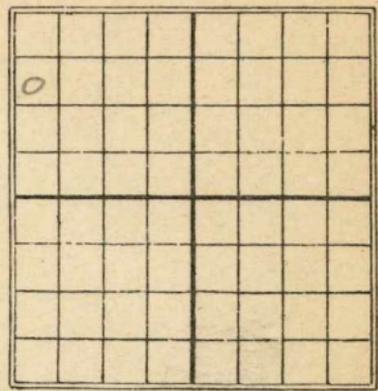

990 Ft. from N. Line

..... Ft. from S. Line

..... Ft. from E. Line

330 Ft. from W. Line

B

Date  
1925

REPORT

4/23

Rig

6/2

Pay 2956-70 420

Bbs Pumping

Will send Completion

Russell

Map No. **KANSAS** Sec. 17 Twp. 12 R. 15 N

Well No. 4 Oswald  
Valerius O + S. Company

Contractor

**FIRST REPORT**

**SECTION PLAT**

990' Ft. from N. Line  
 ----- Ft. from S. Line  
 ----- Ft. from E. Line  
330' Ft. from W. Line

0			

Location -----  
 Rig up ✓ ✓  
 Drilling and Remarks:

**RECORD**

Cased ----- in., ----- ft.  
 Sand -----  
 Gas -----  
 Oil -----  
 Total Depth -----

**PRODUCTION**

1st 24 hrs. Nat. -----  
 1st 24 hrs. after shot -----  
 Gas ----- Cu. Ft.  
 Dry Hole -----  
 Abandoned -----

Date  
APR 23 1925  
 ----- 192

**M. A. BENEAR**  
 ----- Scout

Map No. \_\_\_\_\_ Sec. 17 Twp. 12 R. 15W

Well No. 4 Oswald

\_\_\_\_\_ Valerius O. G. Company

\_\_\_\_\_ Contractor

COMPLETED

SECTION PLAT

990 Ft. from N. Line

\_\_\_\_\_ Ft. from S. Line

\_\_\_\_\_ Ft. from E. Line

330 Ft. from W. Line

0			

Location \_\_\_\_\_

Rig up \_\_\_\_\_

Drilling and Remarks:

Pay 2956-71  
pumping  
420 lbs

RECORD

Cased \_\_\_\_\_ in., \_\_\_\_\_ ft.

Sand \_\_\_\_\_

Gas \_\_\_\_\_

Oil \_\_\_\_\_

Total Depth \_\_\_\_\_

PRODUCTION

1st 24 hrs. Nat. \_\_\_\_\_

1st 24 hrs. after shot \_\_\_\_\_

Gas \_\_\_\_\_ Cu. Ft.

Dry Hole \_\_\_\_\_

Abandoned \_\_\_\_\_

Date

6/9 1925 \_\_\_\_\_ Scout