


Section 6 Township 13 Range 17 W

Well No. # 1 Lang

Company V. D. Sidey & L. J. Dreiling

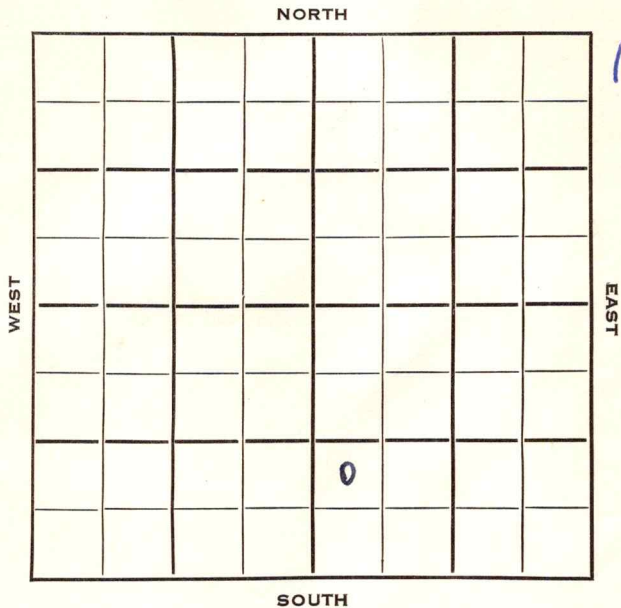

Sec. 6 Twp. 13 R. 17W

Well No. #1 Lang Farm

V. D. Sidey & L. J. Dreiling Company

Sidey Contractor


Ft. from N. Line

990 Ft. from S. Line

Ft. from E. Line

330 Ft. from W. Line

NW SW SE

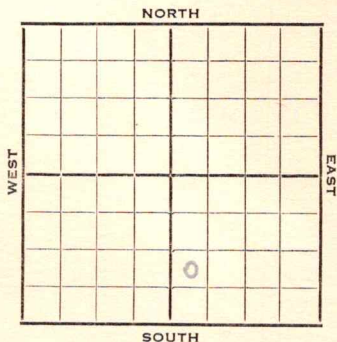

1953

Elev. 2051'

REPORT

7/14

Spud 7-9-53  
8" @ 123  
Drlg. 2367'

7/22

D & A

7/29

D&A

8/5

Spud 7-9-53  
8" @ 123  
Lans 3345  
TD 3645  
D&A

ABANDONED



