


Russell

KANSAS

SECTION 17 TOWNSHIP 12S RANGE 15W

WELL NO. #4 Holland

COMPANY Shields Oil Prod.

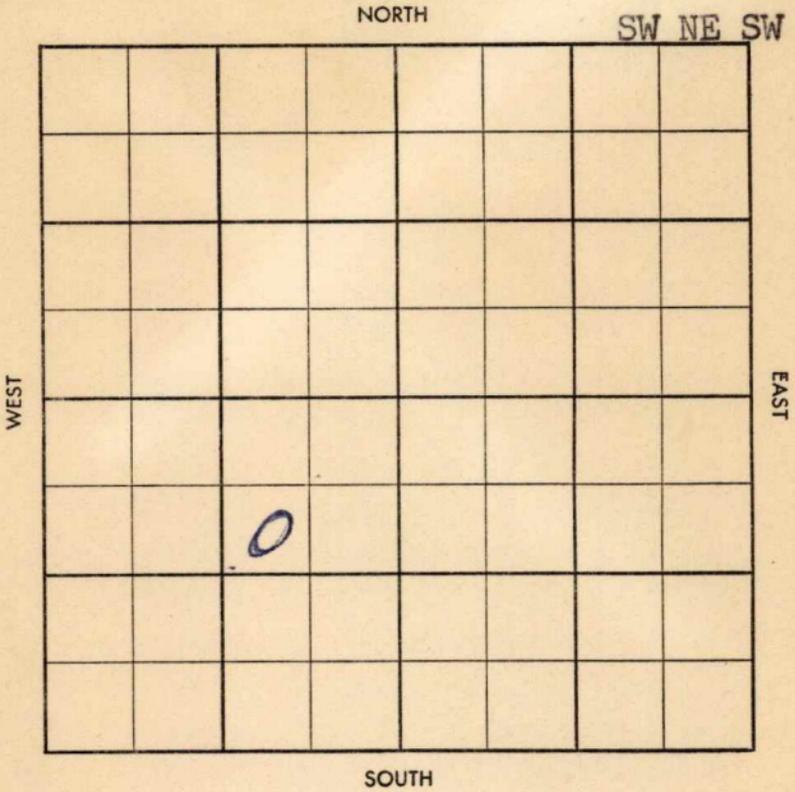

CO. ~~Russell~~

ELEV. ^{1879 AB} 1876.00

SEC. 17

TWP. 12

RGE. 15W

ABANDONED

COMPANY Shields Oil Prod. No. 4

JAN 22 '58

FARM Holland

LOC. SW NE SW

GEOL. _____

CONTR. Co. Tools

POOL Fairport

SPUD 1-2-58

Location JAN 8 '58

8" 935/450

Ø2300 JAN 15 '58

DST 2992-3005

60" 30' 0CM

Press 0 Ø3310

JAN 22 '58

DST 3026-35 60" 30'

50CM BHPO no log

D & A

CO.

LOC.

NO.

SEC.

TWP.

RGE.

CO. Russell ELEV. _____

SEC. 17 TWP. 12 RGE. 15W

COMPANY Shields Oil Prod NO. 4

FIRST REPORT

FARM Holland

LOC. SW NE SW

GEOL. _____

CONTR. Co. Tools

POOL Fairport

SPUD _____

Location

~~4-7~~

CO.
LSE.
NO.
SEC.
TWP.
RGE.