


KANSAS

Barton

Section 3 Township 17 Range 13-N
 Well No. #1 Putman
 Company NU Enamel

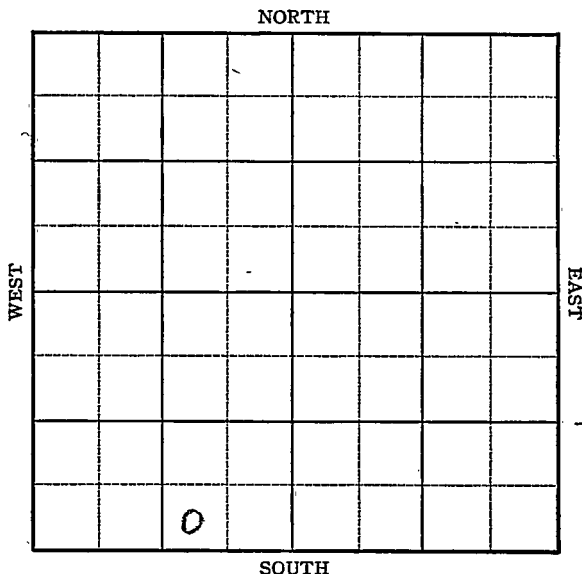

KANSAS

Barton County

Sec. 3 Twp. 17 R. 13W

Well No. #1 Putman Farm

Nu Enamel Company


Susank

 Ft. from N. Line

339 Ft. from S. Line

990 Ft. from E. Line,

 Ft. from W. Line

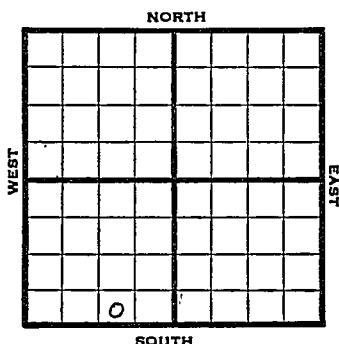

SW SE SW

1946 Elev. 1921 REPORT

1/9 8" @ 810

Dr1g. 1210'

1/10 Lans. 3138' BKC 3308'

Arb 3359-68' T.D. 5" - 3362'

RUST.

1/17 "

1/24 Swab 70 oil 1 hour.

1/30 Arb. 3359

5" @ 3362

TD 3367

Echo Pot. 3521

Max. 3000

Grav. 39.0

COMPLETED



KANSAS

Kansas

Pool Name Susank

Map No. 73 Sec. 3 Twp. 17 R. 13W

Well No. 1 Putman

NU Enamel


Company

FIRST REPORT

Contractor

SW SE SE

SECTION PLAT

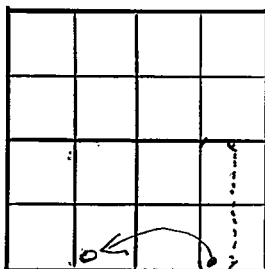

 Ft. from N. Line

330

 Ft. from S. Line

990

 Ft. from E. Line

 Ft. from W. Line

Barton County

Location

Rig up

Drilling and Remarks:

8"-810

1210'

RECORD

Cased in., ft.

Sand

Gas

Oil

Total Depth

PRODUCTION

1st 24 hrs. Nat.

1st 24 hrs. after shot

Gas Cu. Ft.

Dry Hole

Abandoned

Date

DEC 28 1945

19

S. J. LEWIS

Scout

Is this a twin
Well

We show a dry-
Hole 3418 Feet
At this spot

Check your
MAP & ADVISE

Misc. Small Maps	<i>CH</i>
Cards	<i>Parallely</i>
Tracing	
Francia Map	
Courtrough Map	
Pierce Map	
Geological Map	
Pierce's Book	

Sam

Kansas Pool Name SusankMap No. _____ Sec. 3- Twp. 17 R. 13WWell No. 1 Putman

Nu Enamel

Company

CORRECTION

Contractor

SW SE SW

SECTION PLAT

_____ Ft. from N. Line

339 Ft. from S. Line990 Ft. from E. Line

_____ Ft. from W. Line

Barton County

Location _____

Rig up _____

Drilling and Remarks:
reported

SW SE SE

RECORD

Cased _____ in., _____ ft.

Sand _____

Gas _____

Oil _____

Total Depth _____

PRODUCTION

1st 24 hrs. Nat. _____

1st 24 hrs. after shot _____

Gas _____ Cu. Ft.

Dry Hole _____

Abandoned _____

Date

JAN 9 1946

19.

S. J. LEWIS

Scout

KANSAS

Kansas

Pool Name SusankMap No. 23 Sec. 3 Twp. 17 R. 13WWell No. 1 PutmanN U Enamel

Company

COMPLETED

Contractor

SW SE SW

E 1, 1921
SECTION PLAT

	0		

Ft. from N. Line330 Ft. from S. Line990 Ft. from E. LineFt. from W. LineBarton County

Location

Rig up

Drilling and Remarks:


RECORD

Cased _____ in., _____ ft.

Sand _____

Gas _____

Oil _____

Total Depth 2362

PRODUCTION

1st 24 hrs. Nat. _____

1st 24 hrs. after shot _____

Gas _____ Cu. Ft.

Dry Hole _____

Abandoned _____

Date

JAN 30 1945

19

S. J. LEWIS

Scout