


Barton

KANSAS

Section 3 Township 17 Range 13-W

Well No. 1 Putnam

Company Shell

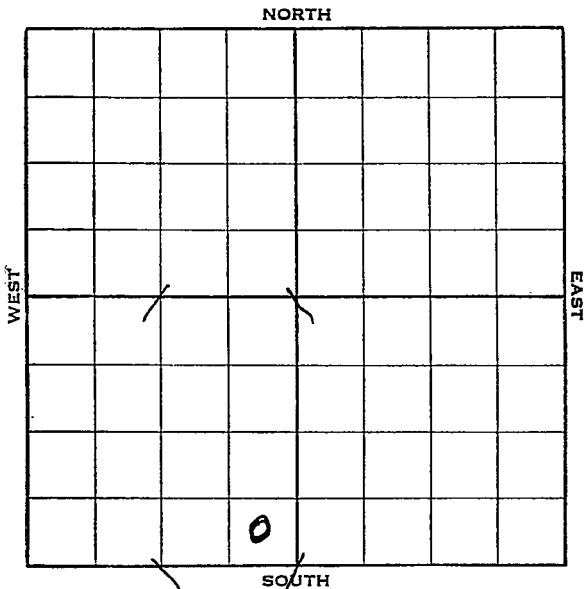

Sec. 3 Twp. 17 R. 13-W

Well No. #1 Putnam Farm


Shell _____ Company

_Ft. from N. Line

330 Ft. from S. Line

330 Ft. from E. Line

_Ft. from W. Line

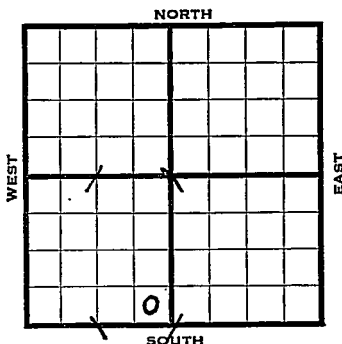

Elev. 1926'.

1938	REPORT
9/21	S. H.
9/30	Dlg.. 2100'..
10/7	Lans. 3151!.. Dlg. 3205'.
10/14	Arb. 3377'. 7" - 3377'.
	T. D. 3396'. 2 bailer oil P.H.
10/20	7" - 3377'.
	Arb. 3377'..
	T. D. 3396'.
	3000 acid.
	Pump 339 oil & 27 water in 8 hrs.
	Potential 1016 bbls.
	COMPLETED
	.
	,

Barton

KANSAS

Map No. 73 Sec. 3 Twp. 17 R. 13WWell No. 1 PutnamShell

Company


Contractor

FIRST REPORT

SE SW

 Ft. from N. Line330 Ft. from S. Line330 Ft. from E. Line Ft. from W. Line

SECTION PLAT

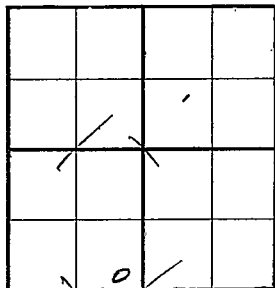Location Rig up

Drilling and Remarks:

SH

RECORD

Cased in., ft.Sand Gas Oil Total Depth

PRODUCTION

1st 24 hrs. Nat. 1st 24 hrs. after shot Gas Cu. Ft.Dry Hole Abandoned

Date

SEP 21 1938

19

H. D. Hatfield

Scout

Barton

KANSAS

Map No. 73 Sec. 3 Twp. 17 R. 13WWell No. 1 Putnam

Shell

Company

Contractor

COMPLETED

SE SW

SECTION PLAT

Ft. from N. Line

330 Ft. from S. Line330 Ft. from E. Line

Ft. from W. Line

Location

RECORD

Cased 7 in. 3377 ft.~~Sand~~ Arb 3377

Gas

Oil

Total Depth 3396

PRODUCTION

1st 24 hrs. Nat.

1st 24 hrs. after shot

Gas Cu. Ft.

Dry Hole

Abandoned

Rig up

Drilling and Remarks:

3000 acidpump 339 oil &27 WTR IN 8 HRSPOT 1016

Date

OCT 19 1938

19

H. D. Hatfield Scout