


Section 3 Township 17 Range 13-W

Well No. 2 Linsner

Company Marylyn & Tuesday Oil

NORTH Ainsworth Pool

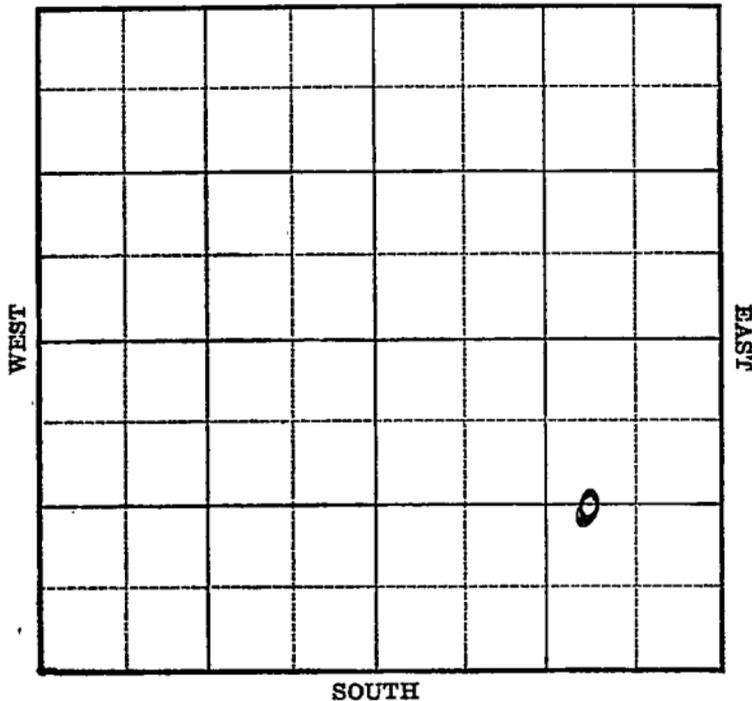

Sec. 3 Twp. 17 R. 13-W

Well No. #2 Linsner Farm

Marylyn & Tuesday Oil Company

(Ainsworth)


\_\_\_\_\_ Ft. from N. Line

1320 Ft. from S. Line

990 Ft. from E. Line

\_\_\_\_\_ Ft. from W. Line

Elev. 1929

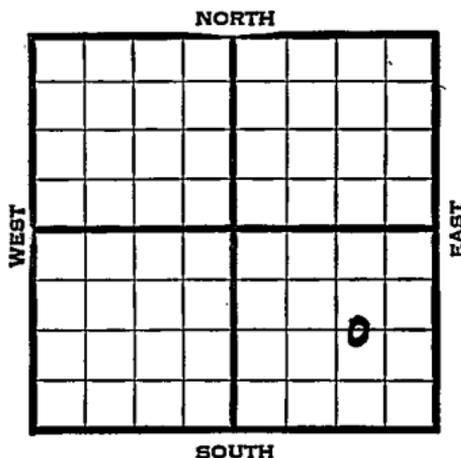

1939	REPORT
5/3	Roty. Rig.
5/12	" "
5/19	13" - 197' Anhy 836'
	Drlg. 2245'
5/26	Arb. <sup>3383 1/2</sup> <del>3386</del> ' 5" - <sup>3383 1/2</sup> <del>3386</del> '
	T.D. 3388'
6/1	S.O. 3386' T.D. 3388'
	Pipe collapsed.
6/7	Arb. 3383 1/2 (Corrected)
	5" 3383 1/2
	T.D. 3395 1/2
	1000 acid
	Pot. 241 pump
	<b>COMPLETED</b>



Barton

Map No. \_\_\_\_\_ Sec. 3 Twp. 17 R. 13W

Well No. 2 Linsner

Marylyn & Tuesday Oil Company

Contractor

COMPLETED

SECTION PLAT

C W L E  $\frac{1}{2}$  SE

\_\_\_\_\_ Ft. from N. Line

1320 Ft. from S. Line

990 Ft. from E. Line

\_\_\_\_\_ Ft. from W. Line

			0

AINSWORTH POOL

Location \_\_\_\_\_

Rig up \_\_\_\_\_

Drilling and Remarks:

*Oil & 3383 1/2 corrected*  
*5" @ 3383 1/2*  
*1000 acid*  
*Po & 241 pump*

RECORD

Cased \_\_\_\_\_ in., \_\_\_\_\_ ft.

Sand \_\_\_\_\_

Gas \_\_\_\_\_

Oil \_\_\_\_\_

Total Depth 3395 1/2

PRODUCTION

1st 24 hrs. Nat. \_\_\_\_\_

1st 24 hrs. after shot \_\_\_\_\_

Gas \_\_\_\_\_ Cu. Ft.

Dry Hole \_\_\_\_\_

Abandoned \_\_\_\_\_

Date

JUN 7 1939 19

S. J. LEWIS

Scout