


Map No. _____ Sec. 17 Twp. 12 R. 15 ^W
 Well No. 16 Oswald Farm _____
Valerious Company _____

_____ Ft. from N. Line
330 Ft. from S. Line
 _____ Ft. from E. Line
990 Ft. from W. Line

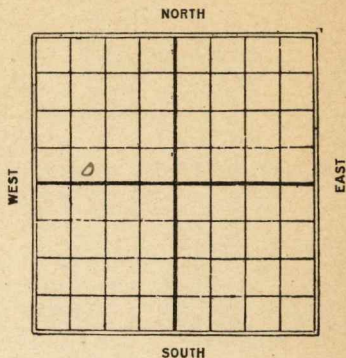

1926
1/13
4/14

REPORT

Location
Sand 3009-3019 1/2
10 bbls per hour

no map
Map No. **KANSAS** Sec. 17 Twp. 12 R. 15W

Well No. 16 OswaldValerious Company

Contractor

SECTION PLAT

-----Ft. from N. Line

330 Ft. from S. Line

-----Ft. from E. Line

990 Ft. from W. Line

0			

FIRST REPORTS

Location -----

Rig up -----

Drilling and Remarks:

Location

RECORD

Cased ----- in., ----- ft.

Sand -----

Gas -----

Oil -----

Total Depth -----

PRODUCTION

1st 24 hrs. Nat. -----

1st 24 hrs. after shot -----

Gas ----- Cu. Ft.

Dry Hole -----

Abandoned -----

Date

JAN 13 1926S. J. LEWIS

Scout

Map No. KANSAS Sec. 17 Twp. 12 R. 15 W

Well No. 16 Oswald

Valerious O & G Company

Contractor

SECTION PLAT

0			

-----Ft. from N. Line

330 Ft. from S. Line

-----Ft. from E. Line

990 Ft. from W. Line

COMPLETED

Location -----

Rig up -----

Drilling and Remarks:

Sand 3009 ft
3019 1/2.

10 gals per hr.

RECORD

Cased ----- in., ----- ft.

Sand -----

Gas -----

Oil -----

Total Depth -----

PRODUCTION

1st 24 hrs. Nat. -----

1st 24 hrs. after shot -----

Gas ----- Cu. Ft.

Dry Hole -----

Abandoned -----

Date

APR 14 1926

S. J. LEWIS

Scout