
Form 51—5M—7-25—19786 A.

Map No. Kansas Sec. 17 Twp. 12 R. 15 W

Well No. 17 Valerious Farm

Valerious. Company

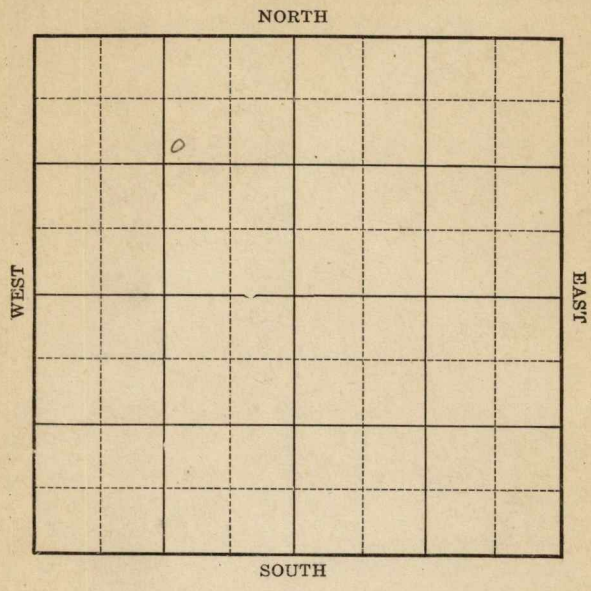

Location

Drilling Remarks

Rig Up

Drilling Remarks

RECORD

Cased in. ft.

Sand

Gas

Oil

Total Depth

PRODUCTION

1st 24 hrs. Nat.

1st 24 hrs. after shot

Gas cu. ft.

Dry Hole

Abandoned

Form 252A—5M—7-25—19684

Map No. Kansas Sec. 17 Twp. 12 R 15 W Russell

Well No. 17 Oswald Valerius Farm


Valerious O. & G. Company

990 Ft. from N. Line

Ft. from S. Line

990 Ft. from E. Line

Ft. from W. Line

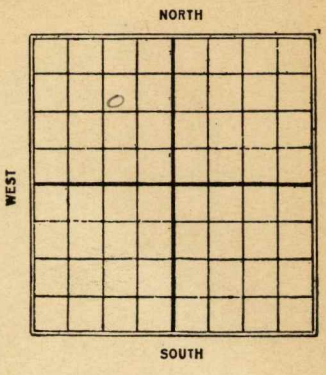

Date 1926	REPORT
3/9	Location
4/14	drilling 1100
4/21	" 1450
4/29	" 2120
5/5	" 2530'
5/12	" 2610'
5/26	" 2712
6/2	" 2981
6/9	T.D. 2999 Drlg 3005'
6/23	Dlg. 3158
6/30	No report
7/14	Sand 2990 - 3163
	48 bbls nat.

Form 26-1M Blks. 3-22-11959.

Reset C
no map


Map No. KANSAS Sec. 17 Twp. 12 R. 15 W

Well No. 17 Oswald Valerius

Valerious Oil & G. Company

Contractor

SECTION PLAT

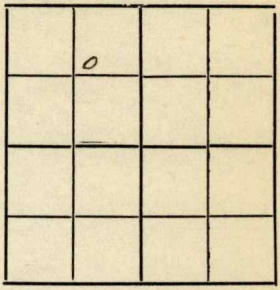

990 Ft. from N. Line

Ft. from S. Line

990 Ft. from E. Line

Ft. from W. Line

FIRST REPORTS

Location

Rig up

Drilling and Remarks:

Location

RECORD

Cased in., ft.

Sand

Gas

Oil

Total Depth

PRODUCTION

1st 24 hrs. Nat.

1st 24 hrs. after shot

Gas Cu. Ft.

Dry Hole

Abandoned

Date

MAR 9 1926

192

S. J. LEWIS

Scout

Form 26–1M Bks. 3-23-11959.

Russell
Township


Map No. KANSAS Sec. 17 Twp. 12 R. 10 W

Well No. 17 Osmond

Valentine Oil Co. Company

Contractor

SECTION PLAT

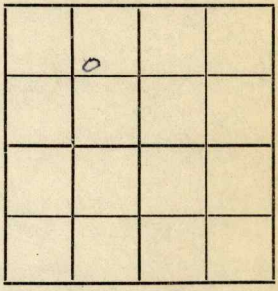

990 Ft. from N. Line

Ft. from S. Line

990 Ft. from E. Line

Ft. from W. Line

COMPLETED

Location

Rig up

Drilling and Remarks:

Sand 2990 ft
3163.

TD 3163 ft.

Vad.

RECORD

Cased in., ft.

Sand

Gas

Oil

Total Depth

PRODUCTION

1st 24 hrs. Nat.

1st 24 hrs. after shot

Gas Cu. Ft.

Dry Hole

Abandoned

Date

JUL 14 1926

192

S. J. LEWIS Scout