
O. W. P. B.

FORM 51 5M 11-44 PETROL KANSAS Barton County

Section 3 Township 17 Range 13W

Well No. #2 Putman "B"

Company Skelly

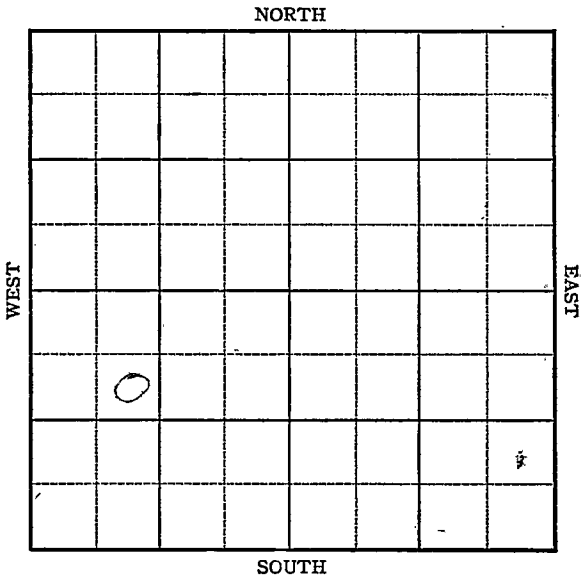

FORM 252-A
5M 3-45 PETROL

KANSAS Barton County O. W. P. B

Sec. 3 Twp. 17 R. 13W

Well No. #2 Putman "B" Farm

Skelly Company


~~Barton~~ S. Ainsworth

990 Ft. from N. Line

Ft. from S. Line

Ft. from E. Line

990 Ft. from W. Line

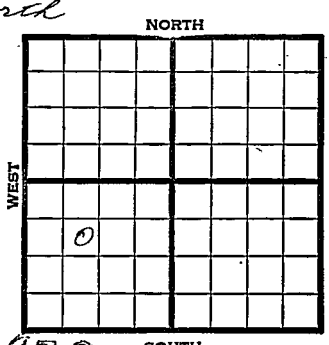

SE NW SW Elev. 1939

1945	1939' REPORT
3/28	Location
4/5	Anhy 820
	8" @ 728 WOC
4/12	Drlg. 1930
4/20	Drlg. 2830
4/27	DRlg. 3287
5/3	Lans 3157
	Arb 3388-92
	TD 3392
	5" @ 3389' RUST
5/10	" " " " "
5/17	" " " " "
5/23	Arb 3388
	5" @ 3389
	TD 3392
	500 acid.
	Pump 117 Pot.
	Grav. 41.6

COMPLETED

1956

O. W. P. B.

1-25	5" @ 3389, PB 3386
	54/ 3290-96, 500 A,
	S/ 21 bo 3 bw 3 hrs.
	PB 3264, 54/ 3232-38, 500 A
	B/ 16 gawph, PB 3216, 63/ 3203-10
	500 A, S/ 31 bo 3 hrs., PB 3190
	96/ 3162-74, 2000 A (OVER)

1-25-56 continued

S/ 45 bo 5 bw 9 hrs.
PB 3155, 36/ 3147-51, 500 A
B/ 6 gawph, DP 3313
Comp. 305 bopd, 21 bw
BL. 3146
L. 3159
A. 3389
TD 3392

FIRST REPORT

COMPLETED

FORM 26 200 BKS. 2-44 PETROL

Pool Name Barton

Map No. 73 Sec. 3 Twp. 17 R. 13W

Well No. 2 Putman "B"

Skelly Company

FIRST REPORT Contractor

SE NW SW


990 Ft. from N. Line

____ Ft. from S. Line

____ Ft. from E. Line

990 Ft. from W. Line

SECTION PLAT

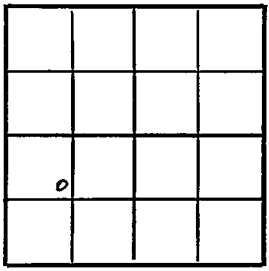

Barton

Location X

Rig up

Drilling and Remarks:

RECORD

Cased ____ in., ____ ft.

Sand

Gas

Oil

Total Depth 3[illegible]

PRODUCTION

1st 24 hrs. Nat.

1st 24 hrs. after shot

Gas ____ Cu. Ft.

Dry Hole

Abandoned

Date

MAR 2 8 1945 19 ____ S. J. LEWIS Scout

FORM 26 200 BKS 2-44 PETROL

Kansas Pool Name Susank

Map No. 13 Sec. 3 Twp. 17 R. 13W

Well No. 2 Putman "B"


Skelly Company

COMPLETED Contractor

SE NW SW

El. 1939

SECTION PLAT

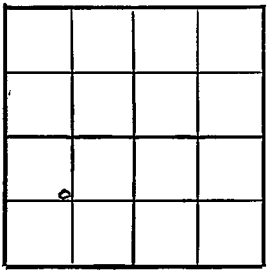

990 Ft. from N. Line

Ft. from S. Line

Ft. from E. Line

990 Ft. from W. Line

Barton County

Location

Rig up

Drilling and Remarks:

Ar 3388

5" @ 3385

500 Acid

Pump 117 BX

41 6 Hr

RECORD

Cased in., ft.

Sand

Gas

Oil

Total Depth 3392

PRODUCTION

1st 24 hrs. Nat.

1st 24 hrs. after shot

Gas Cu. Ft.

Dry Hole

Abandoned

Date

MAY 23 1945 19

S. J. LEWIS Scout

O.W.P.B

FORM 513 REV. SUNRAY

OWPB

County Barton Elev. 1939

Sec. 3 Twp. 17 Rge. 13W

Company Skelly Oil

Farm Name Putman "B" No. 2

TOPS	DEPTH	LOG	DATUM
Anh.			
T.P.			
H.			
Tr.			
Dg.			
B.L.	3146		
L.	3159		
K.C.			
B.K.C.			
Ce.			
C.			
M.			
M.			
K.			
Mz.			
Mq.			
V.			
S.			
S.			
A	3309		
R.			
P€.			
G.			
T.D.	3392		

Loc. in Sec. SE NW SW

Geol.

Contr.

Lse.

Pool S. Ainsworth

FIRST REPORT

JAN 25 '56

COMPLETE

Co.

No.

Sec.

T.

R.

Date Comm.

5" @ 3389 PB 3386 54/ 3290-96

500 A S/ 21 bo 3 bw 3 hr.

PB 3264 54/ 3232-38 500 A

B/ 16 gawph PB 3216 63/ 3203-10

500 A S/ 31 bo 3 hr. PB 3190

96/ 3162-74 2000 A S/ 45 bo

5 bw 9 hr. PB 3155 36/ 3147-51

500 A B/ 6 gawph DP 3313

Comp. 305 bopd 21 bw