

KANSAS


Barton

FORM 51 5M PETROL

Section 3 Township 17 Range 13-W

Well No. #2 Putman

Company NE Enamel

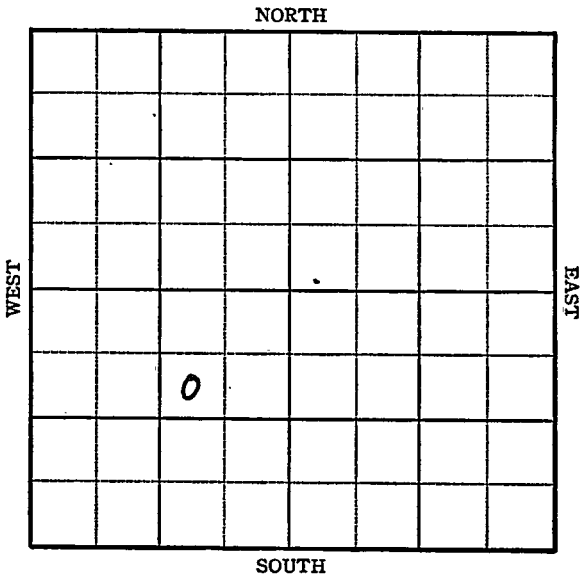

KANSAS


Barton County

Sec. 3 Twp. 17 R. 13Well No. #2 Putman Farm

Nu Enamel Company

Susank

NORTH

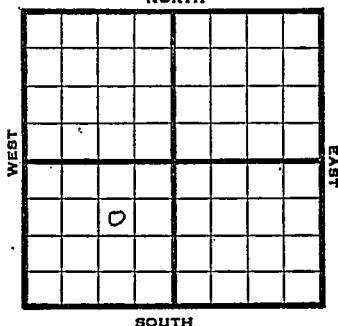

SOUTH

990 Ft. from N. Line

Ft. from S. Line

990 Ft. from E. Line

Ft. from W. Line

SW NE SW

1945

Elev. 1939

REPORT

12/28 8" @ 860' WOC

1946

1/10 Drlg. 3203'

1/17 Lans. 3155' Arb. 3383-87' T.D.

5" - 3384' RUST.

1/24 T.D. 3397' 175' oil.

1/31 1000 acid.

2/7 Pump 25 oil per day.

2/14 " " "

2/21 " " "

2/28 " " "

3/7 " " "

3/14 8" " "

3/21 " " "

3/28 " " "

4/4 " " "

4/10 " " "

4/16 " " "

4/24 Arb. 3383

5" @ 3384

1000 acid.

TD 3397

Pump 25 Pot.

Grav. 36.0

COMPLETED

KANSAS

Kansas Pool Name SusankMap No. K-73 Sec. 3 Twp. 17 R. 13WWell No. 2 - utman

NU Enamel

Company

FIRST REPORT

Contractor

SW NE SW

SECTION PLAT

990 Ft. from N. Line Ft. from S. Line990 Ft. from E. Line Ft. from W. Line

	6		

Barton CountyLocation Rig up

Drilling and Remarks:

8"-860 WOC

RECORD

Cased in., ft.Sand Gas Oil Total Depth

PRODUCTION

1st 24 hrs. Nat. 1st 24 hrs. after shot Gas Cu. Ft.Dry Hole Abandoned Date

DEC 2 8 1945

19

S. J. LEWIS

Scout

KANSAS

Kansas Pool Name SusankMap No. 73 Sec. 3 Twp. 17 R. 13WWell No. 2 PutmanN. U. Enamel

Company

COMPLETED

Contractor

SW NE SW

E 11/989
SECTION PLAT990 Ft. from N. Line Ft. from S. Line990 Ft. from E. Line Ft. from W. Line

	6		

Barton County

Location

Rig up

Drilling and Remarks:

CR 3383
5" @ 3384
1000 acid
Pump 25 ft

*36° Se***RECORD**Cased in., ft.Sand Gas Oil Total Depth 3397**PRODUCTION**1st 24 hrs. Nat. 1st 24 hrs. after shot Gas Cu. Ft.Dry Hole Abandoned

Date

APR 24 1946 19

S. J. LEWIS

Scout