


KANSAS Barton County

Section 3 Township 17 Range 13W

Well No. #1 Putman "B"

Company Skelly

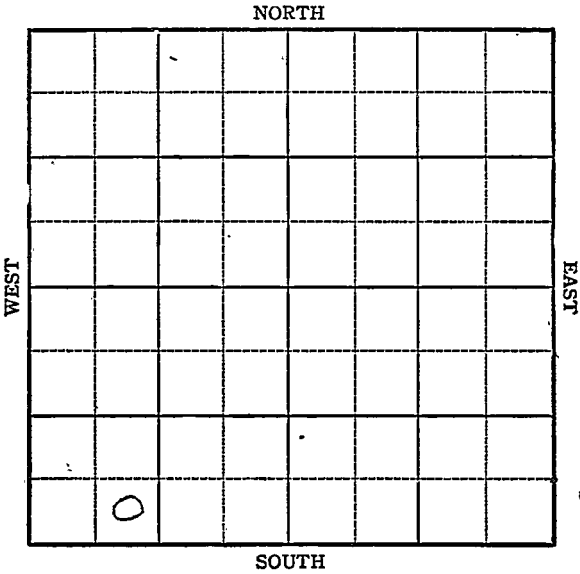

KANSAS

Barton County

Sec. 3 Twp. 17 R. 13W

Well No. #1 Putman "B" Farm

Skelly Company

Ainsworth


         Ft. from N. Line

330 Ft. from S. Line

         Ft. from E. Line

990 Ft. from W. Line

SE SW SW Elev. 1921

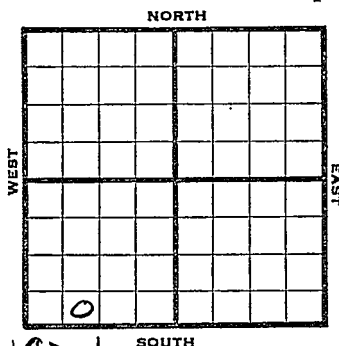

1944

R E P O R T

|       |                                 |
|-------|---------------------------------|
| 10/18 | Rotary                          |
| 10/25 | Lnhy 802                        |
|       | 8" @ 810 WOC                    |
| 11/2  | Drlg. 1840                      |
| 11/8  | Drlg. 2310                      |
| 11/16 | Drlg. 3012'                     |
| 11/24 | Lans 3035 Arb 3364-3368 T D Sat |
|       | 5' @ 3365 RUST                  |
| 11/29 | " " " " " " " "                 |
| 12/6  | Sep. 56 bbl oil in 5 hrs.       |
| 12/14 | 500 acid                        |
|       | Pump 182 oil in 18 hrs          |
| 12/21 | TD 3372                         |
|       | 1000 acid                       |
|       | Pump 80 oil in 5 hrs.           |
| 2/27  | Arb. 3364                       |
|       | 5" @ 3365                       |
|       | 1500 acid                       |
|       | TD 3372                         |
|       | Echo Pot. 2630                  |
|       | Grav. 36.0                      |

COMPLETED

Pool Name AinsworthMap No. YK3W Sec 3 Twp. 17 R. 13WWell No. 1 Putman "B"Skelly

Company

## FIRST REPORT

Contractor

SE SW SW

## SECTION PLAT

|  |  |  |  |
|--|--|--|--|
|  |  |  |  |
|  |  |  |  |
|  |  |  |  |
|  |  |  |  |

Ft. from N. Line

330

Ft. from S. Line

Ft. from E. Line

990

Ft. from W. Line

Barton County

Location

Rig up

Drilling and Remarks:

Rotary

## RECORD

Cased \_\_\_\_\_ in., \_\_\_\_\_ ft.

Sand \_\_\_\_\_

Gas \_\_\_\_\_

Oil \_\_\_\_\_

Total Depth \_\_\_\_\_

## PRODUCTION

1st 24 hrs. Nat. \_\_\_\_\_

1st 24 hrs. after shot \_\_\_\_\_

Gas \_\_\_\_\_ Cu. Ft.

Dry Hole \_\_\_\_\_

Abandoned \_\_\_\_\_

Date

OCT 18 1944 19S. J. LEWIS Scout

Pool Name AinsworthMap No. 13 Sec. 3 Twp. 17 R. 13WWell No. 1 Putman "B"Skelly

Company

**COMPLETED**

Contractor

SE SW SW

## SECTION PLAT

|  |  |  |  |
|--|--|--|--|
|  |  |  |  |
|  |  |  |  |
|  |  |  |  |
|  |  |  |  |

Ft. from N. Line

330

Ft. from S. Line

Ft. from E. Line

990

Ft. from W. Line

Barton County

Location

Rig up

Drilling and Remarks:

*Cor 3364**5" @ 3365**1500 acid**Echo B & 2630**362 ft*

## RECORD

Cased \_\_\_\_\_ in., \_\_\_\_\_ ft.

Sand \_\_\_\_\_

Gas \_\_\_\_\_

Oil \_\_\_\_\_

Total Depth 3322

## PRODUCTION

1st 24 hrs. Nat. \_\_\_\_\_

1st 24 hrs. after shot \_\_\_\_\_

Gas \_\_\_\_\_ Cu. Ft.

Dry Hole \_\_\_\_\_

Abandoned \_\_\_\_\_

Date

DEC 27 194419S. J. LEWIS

Scout