

KANSAS

Barton

Section 3 Township 17 Range 13WWell No. 1 SeyfertCompany Geo. HannumAinsworth
NORTH

WEST

							0

EAST

SOUTH

Barton KANSAS

Sec. 3 Twp. 17 R. 13W

Well No. #1 Seyfert Farm

Geo. Hannum

Company

Ainsworth Pool (Hannum, Cont.)

NORTH


990' Ft. from N. Line

Ft. from S. Line

330' Ft. from E. Line

Ft. from W. Line

SE NE NE

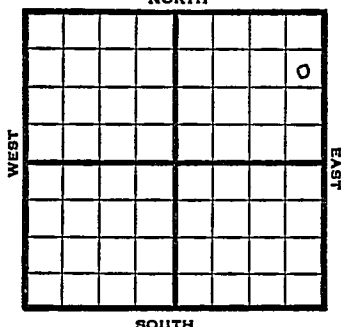

1949

Elev. 1870' REPORT

7/6

8" @ 170'
Anhy 765'
Drlg. 895'
All wells plugged

7/12

Drlg 2900'

7/20

Lansing 3101'
Gorham 3320'
Arb. 3322-27'
TD 3327'
5" @ 3322'

7/27

Swb 6 bbls oil PH 4 hrs.

8/3

"

8/10

"

8/17

"

8/24

"

8/31

"

9/7

Arb 3322'
5" @ 3323'
Pump 63 oil Pot.
Grav. 41
TD 3327'

COMPLETED

Map No. _____ Sec. 3 Twp. 17 R. 13W

Well No. 1 Seyfert

Geo. Hannum _____ Company

Hannum _____ Contractor

SE NE NE


**FIRST REPORT
SECTION PLAT**

990 Ft. from N. Line

_____ Ft. from S. Line

330 Ft. from E. Line

_____ Ft. from W. Line

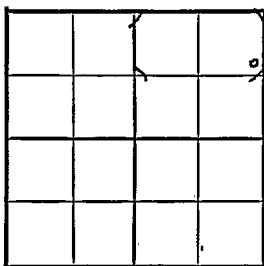

Barton County

Location _____

Rig up _____

Drilling and Remarks:

8" @ 170'

Anhy 765'

drlg. 895'

All wells plugged

RECORD

Cased _____ in., _____ ft.

Sand _____

Gas _____

Oil _____

Total Depth _____

PRODUCTION

1st 24 hrs. Nat. _____

1st 24 hrs. after shot _____

Gas _____ Cu. Ft.

Dry Hole _____

Abandoned _____

Date

JUL 6 1949 19

S. J. LEWIS Scout

Kansas

Map No. K23 Sec. 3 Twp. 17 R. 13WWell No. 1 Seyfert


Geo. Hannum

Company

COMPLETE

Contractor

SE NE NE

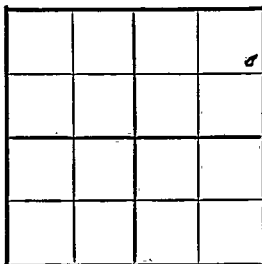E. 1890
SECTION PLAT990 Ft. from N. Line Ft. from S. Line330 Ft. from E. Line Ft. from W. Line

Barton County

Location Rig up

Drilling and Remarks:

Art 33225' 3323Prod 63 oil Prod.41' 3323

RECORD

Cased in., ft.Sand Gas Oil Total Depth 3327

PRODUCTION

1st 24 hrs. Nat. 1st 24 hrs. after shot Gas Cu. Ft. Dry Hole Abandoned

Date

SEP 7 1949

19

S. J. LEWIS

Scout