
Form 51—5M—7-25—19786

Map No. Kansas Sec. 18 Twp. 12 R. 15 W

Well No. 3 Oswald Farm

Kelly Oil Company

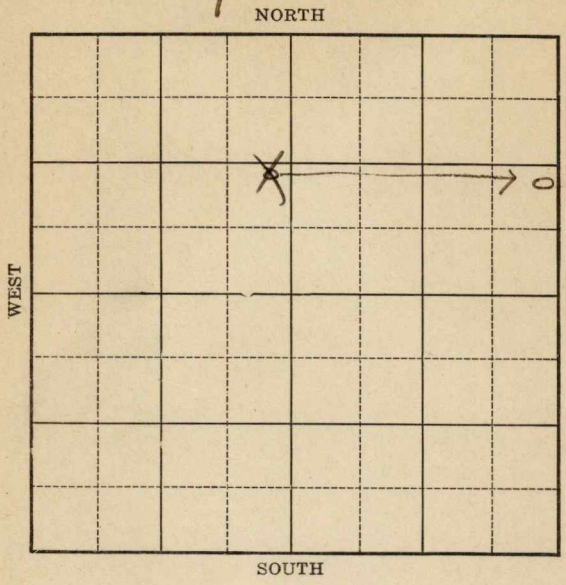

Location

Drilling Remarks

Rig Up

Drilling Remarks

RECORD

Cased in. ft.

Sand

Gas

Oil

Total Depth

PRODUCTION

1st 24 hrs. Nat.

1st 24 hrs. after shot

Gas cu. ft.

Dry Hole


Abandoned

Form 252A—5M—7-25—19684

Map No. KANSAS Sec. 18 Twp. 12 R 15

Well No. 3 Oswald Farm

Skelly Oil Company

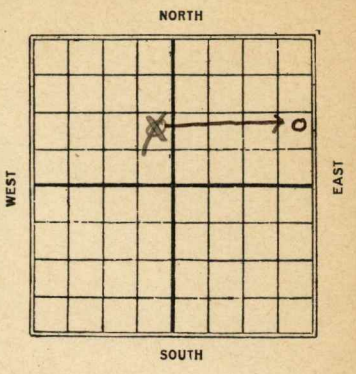

Ft. from N. Line

990 Ft. from S. Line

330 Ft. from E. Line

Ft. from W. Line

1925

Date	REPORT
10/28	R.O.G
11/4 1926	Rig
2/3	Sand 2957 to 2966 2as 666 mat

Form 26—1M Bks.—3-27—11959. No Map

Russell


Map No. KANSAS Sec. 15 Twp. 12 R. 15 W

Well No. 3 Oswald

Shelly Oil Company

Contractor

SECTION PLAT

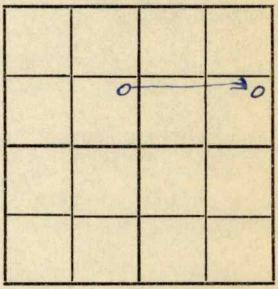

_____Ft. from N. Line

990 Ft. from S. Line

330 Ft. from E. Line

_____Ft. from W. Line

Correction

Location _____

Rig up _____

Drilling and Remarks:

Change Loc from NW 1/4 of NE 1/4

RECORD

Cased _____ in., _____ ft.

Sand _____

Gas _____

Oil _____

Total Depth _____

PRODUCTION

1st 24 hrs. Nat. _____

1st 24 hrs. after shot _____

Gas _____ Cu. Ft.

Dry Hole _____

Abandoned _____

Date

NOV 4 1925

S. J. LEWIS Scout

Form 26—1M Bks. 3-23-11959.

Russell

No Map


Map No. KANSAS Sec. 18 Twp. 12 R. 15 W

Well No. 3 Osmarlak

Shelby Dist. 6 Company

Contractor

SECTION PLAT

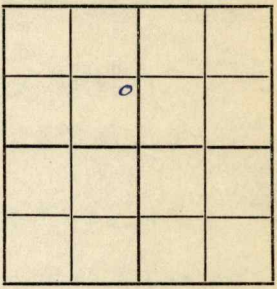

Ft. from N. Line

990 Ft. from S. Line

330 Ft. from E. Line

Ft. from W. Line

FIRST REPORTS

Location

Rig up

Drilling and Remarks:

R.O.G

RECORD

Cased in., ft.

Sand

Gas

Oil

Total Depth

PRODUCTION

1st 24 hrs. Nat.

1st 24 hrs. after shot

Gas Cu. Ft.

Dry Hole

Abandoned

Date

OCT 28 1925

192

S. J. LEWIS Scout

Form 26—AM Bks—3-23-11059.

Nemaha


Map No. KANSAS Sec. 18 Twp. 12 R. 15 W

Well No. 3 Oswald

Skelly Oil Company

Contractor

SECTION PLAT

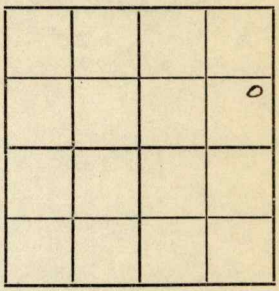

Ft. from N. Line

990 Ft. from S. Line

330 Ft. from E. Line

Ft. from W. Line

COMPLETED

Location

Rig up

Drilling and Remarks:

TD 2957

TD 2966

2008 ls

RECORD

Cased in., ft.

Sand

Gas

Oil

Total Depth

PRODUCTION

1st 24 hrs. Nat.

1st 24 hrs. after shot

Gas Cu. Ft.

Dry Hole

Abandoned

Date

FEB 3 - 1926

192

S. J. LEWIS Scout