

O. W. P. B.

FORM 51 5M 11-44 PETROL

KANSAS


KANSAS

Barton county

Section 3 Township 17 S Range 13W

Well No. $\frac{11}{14}$, ~~Putnam~~ ^{Putnam} "B"

Company Skelly

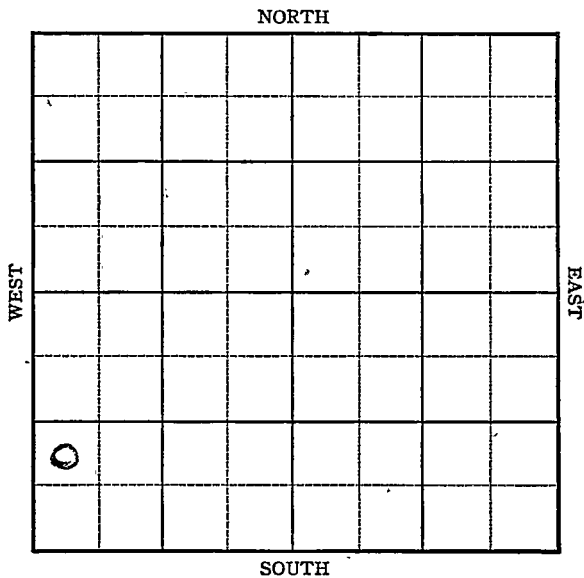

Sec. 3 Twp. 17 S R. 13W

Well No. #4 Putnam "B" Farm

Skelly Company

~~S. Ainsworth - Pool~~
~~Susank~~


Ft. from N. Line

990 Ft. from S. Line

Ft. from E. Line

330 Ft. from W. Line

NW SW SW

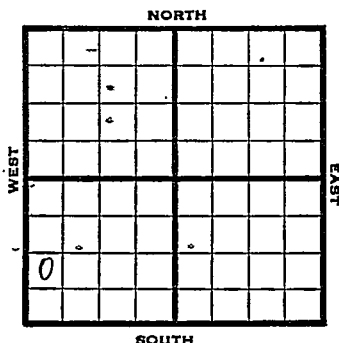

1946 Elev. 1911 REPORT

5/15 Location

5/21 Anhy 831

8" @ 835'

Drlg 1440'

5/29 Lans 3128

Arb. 3368

TD 3371'

Run 5"

6/5 5" @ 3369 RUST

6/12 TD 3384

Swb 22 oil in 7 hrs.

6/18 TD 3390'

500 acid pump 41 oil in 8 hrs.

6/26 " " "

7/3 " " "

7/9 " " "

7/16 " " "

7/23 " " "

7/31 Arb. 3368

5" @ 3369

TD 3390'

Pump 130 Pot.

Grav. 39.0

COMPLETED

OVER

1955
12/28

O. W. P. B.

OTD 3390' 5" @ 3371 PB 3362
45/3356-61 600 A Petrofrac.
PB 3240 60/3210-20 500 A
S/15 BW 10 hr. PB 3206 24/3200-04
500 A S/24 BW 13 hrs. PB 3190'
36/3180-84 2750 A S/65 BO 1 BW
14 hrs. PB 3170 72/3150-58
2250 A. S/3/4 BO 3/4 BW 3 hrs.
PB 3146 48/3138-44 1000 A
S/9 BO 3 hr. DP 3188 P/51 BO
3 BW. Comp. TD 3390
L. 3137'. A. 3366'

FIRST REPORT

COMPLETED

~~KANSAS~~

Kansas

Pool Name SusankMap No. 13 Sec. 3 Twp. 17 R. 13WWell No. 4 Pietzman "B"Skelly

Company

FIRST REPORT

Contractor

NW SW SW

SECTION PLAT

0			

 Ft. from N. Line990 Ft. from S. Line Ft. from E. Line330 Ft. from W. LineBarton CountyLocation ✓Rig up

Drilling and Remarks:

RECORD

Cased in., ft.Sand Gas Oil Total Depth

PRODUCTION

1st 24 hrs. Nat. 1st 24 hrs. after shot Gas Cu. Ft.Dry Hole Abandoned ✓

Date

MAY 15 1946 19S. J. LEWIS

Scout

KANSAS

Kansas

Pool Name Susank PoolMap No. _____ Sec. 3 Twp. 17 R. 13WWell No. 4 Putman "B"Skelly

Company _____

COMPLETED

Contractor _____

NW SW SW

E 1/1911
SECTION PLAT

0			

_____ Ft. from N. Line

990 _____ Ft. from S. Line

_____ Ft. from E. Line

330 _____ Ft. from W. LineBarton County

Location _____

Rig up _____

Drilling and Remarks:

CR 433685" @ 3368Prod 130 BX330 - 4**RECORD**

Cased _____ in., _____ ft.

Sand _____

Gas _____

Oil _____

Total Depth 3380**PRODUCTION**

1st 24 hrs. Nat. _____

1st 24 hrs. after shot _____

Gas _____ Cu. Ft.

Dry Hole _____

Abandoned _____

Date

JUL 3 1 1945 19S. J., LEWIS Scout

O. W. P. B.

FORM 513 REV. SUNRAY

OWPB

County Barton Elev. 1911
 Sec. 3 Twp. 17 Rge. 13W
 Company Skelly Oil
 FarmName Putnam "B" No. 4

TOPS	DEPTH	LOG	DATUM	Loc. in Sec.
Anh.				NW SW SW
Tp.				
H.				
Tr.				
Dg.				
Bl.				
L.		3137		Geol.
K.C.				Contr.
B.K.C.				
Ce.				
C.				
M.				
M.				Pool
K.				S. Ainsworth
Mz.				
Mo.				
V.				
S.				
S.		3366		
A				
R.				
P.E.				
G.				
T.D.	3390			

FIRST REPORT
 COMPLETE
 DEC 28 '53

Date Comm.

OTD 3390 5" @ 3371 PB 3362 45/ 3356-

61 600 A petrofrac PB 3240

60/ 3210-20 500 A S/ 15 bw 10 hr.

PB 3206 24/ 3200-04 500 A S/ 24 bw

13 hr. PB 3190 36/ 3180-84 2750 A

S/ 65 bo 1 bw 14 hr. PB 3170

72/ 3150-58 2250 A S/ 3/4 bo 3/4 bw

3 hr. PB 3146 48/ 3138-44 1000 A

S/ 9 bo 3 hr. DP 3188 P/ 51 bo 3 bw

Comp.